

NOTICE OF INTENTION TO DRILL

(see rules on reverse side)

Starting Date 12 1 85 month day year

API Number 15- 155-21,074-0000

OPERATOR: License # 5097
Name Martin Oil Producers, Inc.
Address 1010 Union Center
City/State/Zip Wichita, KS 67202
Contact Person K. S. Martin
Phone 264-0352

NE SW SW Sec 35 Twp. 23 S, Rg 5
990 Ft. from South Line of Section
4290 Ft. from East Line of Section

(Note: Locate well on Section Plat on reverse side)

CONTRACTOR: License # 5929
Name Duke Drilling Co. Inc.
City/State Great Bend, KS 67530

Nearest lease or unit boundary line 330 feet

County Reno

Lease Name Bacon Well # 2

Ground surface elevation 1499 feet MSL

Well Drilled For: Well Class: Type Equipment:
X Oil SWD Infield X Mud Rotary
Gas Inj X Pool Ext. Air Rotary
OWWO Expl Wildcat Cable

Domestic well within 330 feet: yes X no

Municipal well within one mile: yes X no

Surface pipe by Alternate: 1 X 2

Depth to bottom of fresh water 200

Depth to bottom of usable water 220

Surface pipe planned to be set 650

Projected Total Depth 3900

Formation Simpson

If OWWO: old well info as follows:

Operator
Well Name
Comp Date Old Total Depth

220' conductor required

I certify that well will comply with K.S.A. 55-101, et seq., plus eventually plugging hole to KCC specifications.

cementing will be done immediately upon setting production casing.

Date 11/14/85 Signature of Operator or Agent Title President

For KCC Use: Conductor Pipe Required 220 feet; Minimum Surface Pipe Required feet per Alt. 1 2


This Authorization Expires 5-15-86 Approved By 11-15-85

Must be filed with the K.C.C. five (5) days prior to commencing well
This card void if drilling not started within six (6) months of date received by K.C.C.

Important procedures to follow:

1. Notify District office before setting surface casing.
2. Set surface casing by circulating cement to the top.
3. File completion forms ACO-1 with K.C.C. within 90 days of well completion, following instructions on ACO-1, side 1, and including copies of wireline logs.
4. Notify District office 48 hours prior to old well workover or re-entry.
5. Prior to filing Intent, prepare a proposed plugging plan in case well is D & A, then obtain approval of plan when calling district office prior to setting surface pipe.
6. Submit plugging report (CP-4) to K.C.C. after plugging is completed.
7. Obtain an approved injection docket number before disposing of salt water.
8. Notify K.C.C. within 10 days when injection commences or terminates.
9. If an alternate 2 completion, cement in the production pipe from below any usable water to surface within 120 days of spud date.

A Regular Section of Land
1 Mile = 5,280 Ft.

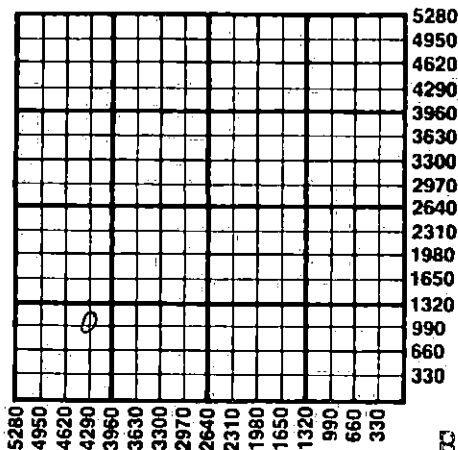

RECEIVED
STATE CORPORATION COMMISSION

NOV 15 1985
11-15-85
CONSERVATION DIVISION
Wichita Kansas

State Corporation Commission of Kansas
Conservation Division
200 Colorado Derby Building
Wichita, Kansas 67202
(316) 263-3238