

CARD MUST BE TYPED

State of Kansas
NOTICE OF INTENTION TO DRILL
(see rules on reverse side)

CARD MUST BE SIGNED

Starting Date: July 28, 1984
month day year

API Number 15- 155-21,003-0000

OPERATOR: License # 5565

NE SW SE .. Sec. 24. Twp. 23 S, Rge. 5... East West

Name .. National Cooperative Refinery Assoc.

Address Box 6

..... 990 ... Ft North from Southeast Corner of Section

City/State/Zip Great Bend, KS, 67530

..... 1650 ... Ft West from Southeast Corner of Section

Contact Person Irving J. Gotsche

Phone 316 793-7824

(Note: Locate well on Section Plat on reverse side)

Nearest lease or unit boundary line 990 feet.

County Reno

Lease Name Bontrager Well# 1

Domestic well within 330 feet : yes no

Municipal well within one mile : yes no

CONTRACTOR: License # 6739

Name Kaw Drlg. Co., Inc.

City/State Wichita, Kansas 67202

Well Drilled For: Well Class: Type Equipment:

- Oil Swd Infield Mud Rotary
- Gas Inj Pool Ext. Air Rotary
- OWWO Expl Wildcat Cable

If OWWO: old well info as follows:

Operator

Well Name

Comp Date Old Total Depth

Projected Total Depth 3950 feet

Projected Formation at TD Simpson Sand

Expected Producing Formations Simpson, L-KC

Depth to Bottom of fresh water 100 feet

Lowest usable water formation *Niangua sh. 125*

Depth to Bottom of usable water ~~725~~ *725/135*

Surface pipe by Alternate : 1 2

Surface pipe to be set 700 feet

Conductor pipe if any required 125 feet

Ground surface elevation 1500 feet MSL

This Authorization Expires *11/13/85*

Approved By *[Signature]* *7/13/84*

I certify that we will comply with K.S.A. 55-101, et seq., plus eventually plugging hole to K.C.C. specifications.

Date July 11, 1984 Signature of Operator or Agent


Irving J. Gotsche

Title District Supt.

mhc/KOHE 7-13-84

Must be filed with the K.C.C. five (5) days prior to commencing well
This card void if drilling not started within six (6) months of date received by K.C.C.

A Regular Section of Land
1 Mile = 5,280 Ft.

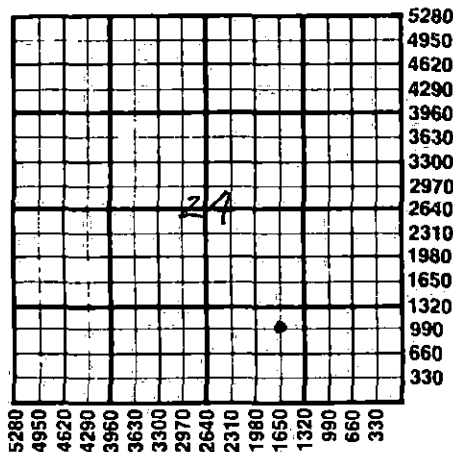

Important procedures to follow:

1. Notify District office before setting surface casing.
2. Set surface casing by circulating cement to the top.
3. File completion forms ACO-1 with K.C.C. within 90 days of well completion, following instructions on ACO-1, side 1, and including copies of wireline logs.
4. Notify District office 48 hours prior to old well workover or re-entry.
5. Prior to plugging, prepare a plugging plan, then obtain agreement from the appropriate district office for an approved plugging plan.
6. Submit plugging report (CP-4) to K.C.C. after plugging is completed.
7. Obtain an approved injection docket number before disposing of salt water.
8. Notify K.C.C. within 10 days when injection commences or terminates.
9. If an alternate 2. completion, cement in the production pipe from below any usable water to surface within 120 days of spud date.

State Corporation Commission of Kansas
Conservation Division
200 Colorado Derby Building
Wichita, Kansas 67202
(316) 263-3238

RECEIVED
STATE CORPORATION COMMISSION
1111 13 1984
7-13-84
CONSERVATION DIVISION
Wichita, Kansas