

CARD MUST BE TYPED

State of Kansas  
NOTICE OF INTENTION TO DRILL

(see rules on reverse side)

CARD MUST BE SIGNED

Collection  
11-12-86

Starting Date ..... November 16, 1986  
month day year

API Number 15- 151-21,815-00-00

OPERATOR: License # ..... 5046  
Name ..... Raymond Oil Company, Inc.  
Address ..... P. O. Box 48788  
City/State/Zip ..... Wichita, Kansas 67201  
Contact Person ..... Pat Raymond, Vice President  
Phone ..... 316/267-4214

SE. SW. SW. Sec. 8 Twp. 29 S, Rg. 15  
330 ..... Ft. from South Line of Section  
4290 ..... Ft. from East Line of Section

(Note: Locate well on Section Plat on reverse side)

\* CONTRACTOR: License # ..... uni 5829  
Name ..... A. Debeaux, O.R.G. Co., Inc.  
City/State ..... Wichita, KS

Nearest lease or unit boundary line ..... 330 ..... feet  
County ..... Pratt

Well Drilled For: Well Class: Type Equipment:  
 Oil  SWD  Infield  Mud Rotary  
 Gas  Inj  Pool Ext.  Air Rotary  
 OWWO  Expl  Wildcat  Cable

Lease Name ..... Watson Well # 3  
Ground surface elevation Est. 2060 ..... feet MSL  
Domestic well within 330 feet:  yes  no  
Municipal well within one mile:  yes  no  
Surface pipe by Alternate: I  2

If OWWO: old well info as follows:

Operator .....  
Well Name .....  
Comp Date ..... Old Total Depth .....

Depth to bottom of fresh water ..... 180' .....  
Depth to bottom of usable water ..... 300' 220 .....  
Surface pipe planned to be set ..... 350+ .....  
Projected Total Depth ..... 4850 ..... feet  
Formation ..... Arbuckle

I certify that well will comply with K.S.A. 55-101, et seq., plus eventually plugging hole to KCC specifications.

(2-2402)

Date Nov 5, 1986 Signature of Operator or Agent Pat Raymond Title Vice President  
Pat Raymond


For KCC Use:  
Conductor Pipe Required ..... feet; Minimum Surface Pipe Required ..... 250 feet per Alt. as above  
This Authorization Expires ..... 5-6-87 ..... Approved By ..... 11-6-86 [Signature]

Must be filed with the K.C.C. five (5) days prior to commencing well  
This card void if drilling not started within six (6) months of date received by K.C.C.

**Important procedures to follow:**

1. Notify District office before setting surface casing.
2. Set surface casing by circulating cement to the top.
3. File completion forms ACO-1 with K.C.C. within 90 days of well completion, following instructions on ACO-1, side 1, and including copies of wireline logs.
4. Notify District office 48 hours prior to old well workover or re-entry.
5. Prior to filing Intent, prepare a proposed plugging plan in case well is D & A, then obtain approval of plan when calling district office prior to setting surface pipe.
6. Submit plugging report (CP-4) to K.C.C. after plugging is completed.
7. Obtain an approved injection docket number before disposing of salt water.
8. Notify K.C.C. within 10 days when injection commences or terminates.
9. If an alternate 2 completion, cement in the production pipe from below any usable water to surface within 120 days of spud date.

**A Regular Section of Land**  
1 Mile = 5,280 Ft.

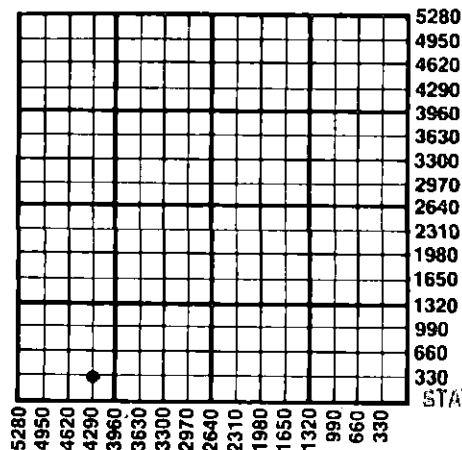

11-6-86

RECEIVED  
NOV 6 1986  
STATE CORPORATION COMMISSION  
CONSERVATION DIVISION  
Wichita, Kansas

State Corporation Commission of Kansas  
Conservation Division  
200 Colorado Derby Building  
Wichita, Kansas 67202  
(316) 263-3238