

CARD MUST BE TYPED

State of Kansas

CARD MUST BE SIGNED

NOTICE OF INTENTION TO DRILL

Corrected

(see rules on reverse side)

Expected Spud Date. 6 16 1988
month day year

OPERATOR: License # 09408

Name Trans Pacific Oil Corporation

Address 410 One Main Place

City/State/Zip Wichita, Ks. 67202

Contact Person Alan D. Banta

Phone 316-262-3596

CONTRACTOR: License # 05841

Name Trans Pac Drilling, Inc.

City/State Wichita, Ks. 67202

Well Drilled For: Well Class: Type Equipment:

<input checked="" type="checkbox"/> Oil	<input type="checkbox"/> Storage	<input type="checkbox"/> Infield	<input checked="" type="checkbox"/> Mud Rotary
<input type="checkbox"/> Gas	<input type="checkbox"/> Inj.	<input checked="" type="checkbox"/> Pool Ext.	<input type="checkbox"/> Air Rotary
<input type="checkbox"/> OWWO	<input checked="" type="checkbox"/> Expl.	<input type="checkbox"/> Wildcat	<input type="checkbox"/> Cable

If OWWO: old well info as follows:

Operator

Well Name

Comp Date Old Total Depth

I certify that well will comply with K.S.A. 55-101, et seq., plus eventually plugging hole to KCC specifications.

Date 8/23/88 Signature of Operator or Agent [Signature] Title Office Manager

For KCC Use:

Conductor Pipe Required feet; Minimum Surface Pipe Required 260 feet per Alt. (1) X

This Authorization Expires 12-9-88 Approved By [Signature] 6-9-88

EFFECTIVE DATE: 6-14-88

API Number 15-151-21,885-40-00

E/2
NE SE NE 25 26 13 East
3630 3300 S, Rg. X West
330 Ft. from South Line of Section
330 Ft. from East Line of Section

(Note: Locate well on Section Plat on reverse side)

Nearest lease or unit boundary line 330 feet

County Pratt

Lease Name Hoeme Well # 1

Ground surface elevation est. 1920 feet MSL

Domestic well within 330 feet: ___yes ___no

Municipal well within one mile: ___yes ___no

Depth to bottom of fresh water 240

Depth to bottom of usable water 240

Surface pipe by Alternate: 1 X 2

Surface pipe planned to be set 260

Conductor pipe required 4200

Projected Total Depth feet

Formation Arbuckle


EFFECTIVE DATE: 6-14-88

Must be filed with the K.C.C. five (5) days prior to commencing well
This card void if drilling not started within six (6) months of date received by K.C.C.

Important procedures to follow:

1. Notify District office before setting surface casing.
2. Set surface casing by circulating cement to the top.
3. File completion forms ACO-1 with K.C.C. within 120 days of well spud date, following instructions on ACO-1, side 1, and including copies of wireline logs.
4. Notify District office 48 hours prior to old well workover or re-entry.
5. Prior to filing Intent, prepare a proposed plugging plan in case well is D & A, then obtain approval of plan when calling district office prior to setting surface pipe.
6. Submit plugging report (CP-4) to K.C.C. after plugging is completed.
7. Obtain an approved injection docket number before disposing of salt water.
8. Notify K.C.C. within 10 days when injection commences or terminates.

A Regular Section of Land
1 Mile = 5,280 Ft.

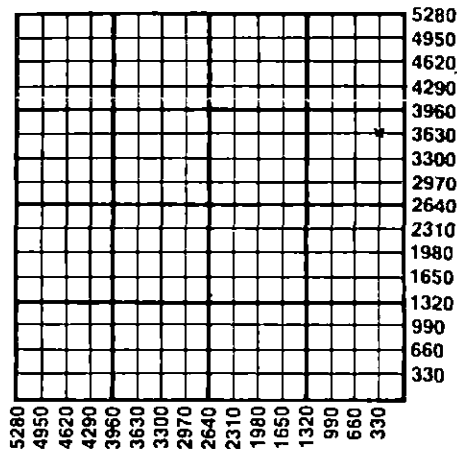

RECEIVED
STATE CORPORATION COMMISSION
STATE CORPORATION
completion, cement in the production pipe from
below any usable water to surface within 120 days of spud date.

6-9-88 JUN 9 1988

CONSERVATION DIVISION
Wichita, Kansas

State Corporation Commission of Kansas
Conservation Division
200 Colorado Derby Building
Wichita, Kansas 67202-1212
(316) 263-3238