

CARD MUST BE TYPED

State of Kansas

CARD MUST BE SIGNED

NOTICE OF INTENTION TO DRILL

CORRECTED LOCATION

✓ 10

(see rules on reverse side)

Expected Spud Date. 6 16 88
month day year

API Number 15— 151-21,885 - 00 - 00

OPERATOR: License # 09408
Name Trans. Pacific Oil Corporation
Address 410 One Main Place
City/State/Zip Wichita, Ks. 67202
Contact Person Alan D. Banta
Phone 316-262-3596

* E 1/2 SE NE Sec. 25 Twp. 26 S, Rg. 13
* 3300 Ft. from South Line of Section
330 Ft. from East Line of Section

(Note: Locate well on Section Plat on reverse side)

CONTRACTOR: License # 05841
Name Trans. Pac Drilling, Inc.
City/State Wichita, Ks. 67202

Nearest lease or unit boundary line 330 feet
County Pratt
Lease Name Hoeme Well # 1

Well Drilled For: Well Class: Type Equipment:
 Oil Storage Infield Mud Rotary
 Gas Inj Pool Ext. Air Rotary
 OWWO Expl Wildcat Cable

Ground surface elevation . . . est . . . 1920 feet MSL
Domestic well within 330 feet: yes no
Municipal well within one mile: yes no

If OWWO: old well info as follows:

Depth to bottom of fresh water 240
Depth to bottom of usable water 240
Surface pipe by Alternate: 1 2

Operator
Well Name
Comp Date Old Total Depth

Surface pipe planned to be set 260
Conductor pipe required
Projected Total Depth 4200 feet
Formation Argbuckle

I certify that well will comply with K.S.A. 55-101, et seq., plus eventually plugging hole to KCC specifications.

Date 6/10/88 Signature of Operator or Agent

Title Office Manager

For KCC Use:

Conductor Pipe Required feet; Minimum Surface Pipe Required 260 feet per Alt. ① X

This Authorization Expires 12-9-88 Approved By RCH 6-9-88

WAS: NE SE NE 3630 FSL


EFFECTIVE DATE: 6-14-88

Must be filed with the K.C.C. five (5) days prior to commencing well
 This card void if drilling not started within six (6) months of date received by K.C.C.

Important procedures to follow:

A Regular Section of Land
 1 Mile = 5,280 Ft.

1. Notify District office before setting surface casing.
2. Set surface casing by circulating cement to the top.
3. File completion forms ACO-1 with K.C.C. within 120 days of well spud date, following instructions on ACO-1, side 1, and including copies of wireline logs.
4. Notify District office 48 hours prior to old well workover or re-entry.
5. Prior to filing Intent, prepare a proposed plugging plan in case well is D & A, then obtain approval of plan when calling district office prior to setting surface pipe.
6. Submit plugging report (CP-4) to K.C.C. after plugging is completed.
7. Obtain an approved injection docket number before disposing of salt water.
8. Notify K.C.C. within 10 days when injection commences or terminates.

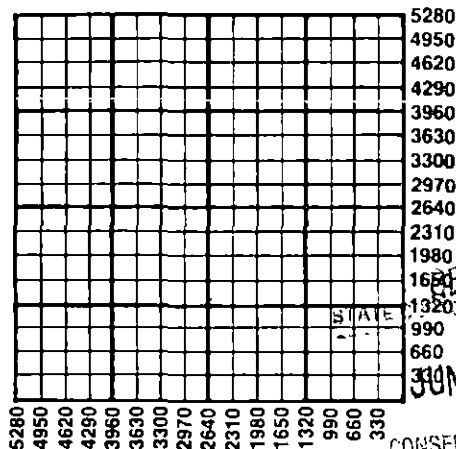

If an alternate 2 completion, cement in the production pipe from below any usable water to surface within 120 days of spud date.

State Corporation Commission of Kansas
 Conservation Division
 200 Colorado Derby Building
 Wichita, Kansas 67202-1212
 (316) 263-3238