

CARD MUST BE TYPED

State of Kansas
NOTICE OF INTENTION TO DRILL
 (see rules on reverse side)

CARD MUST BE SIGNED

Starting Date: 10 1 84
 month day year

OPERATOR: License # 9668
 Name Imperial Oil & Gas, Inc.
 Address 720 Fourth Financial Center
 City/State/Zip Wichita, Kansas 67202
 Contact Person Barbara Waitt
 Phone 316/263-5205

CONTRACTOR: License # 5829
 Name Aldebaran Drilling Co., Inc.
 City/State Wichita, Kansas

Well Drilled For:	Well Class:	Type Equipment:
☒ Oil ☐ Swd ☐ Infield ☒ Mud Rotary		
☒ Gas ☐ Inj ☒ Pool Ext. ☐ Air Rotary		
☐ OWWO ☐ Expl ☐ Wildcat ☐ Cable		

If OWWO: old well info as follows:

Operator
 Well Name
 Comp Date Old Total Depth
 Projected Total Depth 4800 feet
 Projected Formation at TD Simpson
 Expected Producing Formations

I certify that we will comply with K.S.A. 55-101, et seq., plus eventually plugging hole to K.C.C. specifications.

Date 9/25/84 Signature of Operator or Agent

API Number 15- 151-21,487-00-00
 C SE SE NE Sec 5 Twp 29 S, Rge 15
 (location) ☐ East ☒ West

2970 Ft North from Southeast Corner of Section
 330 Ft West from Southeast Corner of Section
 (Note: Locate well on Section Plat on reverse side)

Nearest lease or unit boundary line 330 feet.
 County Pratt
 Lease Name LAIRD Well# 1-5
 Domestic well within 330 feet: ☐ yes ☒ no
 Municipal well within one mile: ☐ yes ☒ no

Depth to Bottom of fresh water 110 feet
 Lowest usable water formation Cheyenne Sandstones
 Depth to Bottom of usable water 300 feet
 Surface pipe by Alternate: 1 ☒ 2 ☐
 Surface pipe to be set 400 feet
 Conductor pipe if any required feet
 Ground surface elevation feet MSL
 This Authorization Expires 3-27-85
 Approved By 9-27-84


Robert Choult
 Title Vice President

mhc/KOHE 9/27/84

Must be filed with the K.C.C. five (5) days prior to commencing well
This card void if drilling not started within six (6) months of date received by K.C.C.

Important procedures to follow :

A Regular Section of Land
1 Mile = 5,280 Ft.

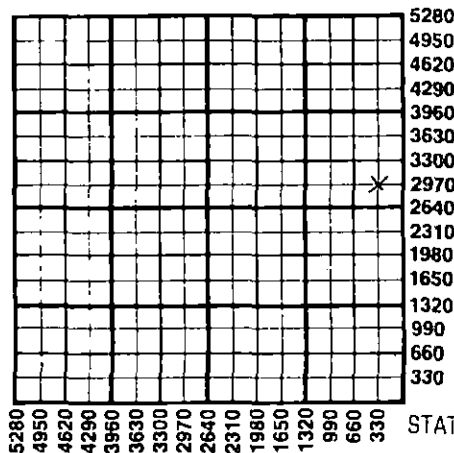

1. Notify District office before setting surface casing.
2. Set surface casing by circulating cement to the top.
3. File completion forms ACO-1 with K.C.C. within 90 days of well completion, following instructions on ACO-1, side 1, and including copies of wireline logs.
4. Notify District office 48 hours prior to old well workover or re-entry.
5. Prior to plugging, prepare a plugging plan, then obtain agreement from the appropriate district office for an approved plugging plan.
6. Submit plugging report (CP-4) to K.C.C. after plugging is completed.
7. Obtain an approved injection docket number before disposing of salt water.
8. Notify K.C.C. within 10 days when injection commences or terminates.
9. If an alternate 2 completion, cement in the production pipe from below any usable water to surface within 120 days of spud date.

RECEIVED

STATE CORPORATION COMMISSION

State Corporation Commission of Kansas

Conservation Division

200 Colorado Derby Building

Wichita, Kansas 67202

(316) 263-3238

CONSERVATION DIVISION

Wichita, Kansas

9-27-84

SEP 27 1984