

CARD MUST BE TYPED

State of Kansas
NOTICE OF INTENTION TO DRILL
(see rules on reverse side)

CARD MUST BE SIGNED

Starting Date: October 23, 1984
month day year 1-40

API Number 15-

151-21,504-00-00

OPERATOR: License # 5234
Name Penguin Petroleum, Inc.
Address 1250 Kansas State Bank Bldg.
City/State/Zip Wichita, Kansas 67202
Contact Person W. C. Talbott
Phone 267-3393 (Bus.) 683-7057 (Res.)

SE NE SE Sec 5 Twp 29S S, Rge 15W East
(location) West

1650 Ft North from Southeast Corner of Section
330 Ft West from Southeast Corner of Section
(Note: Locate well on Section Plat on reverse side)

CONTRACTOR: License # 5146
Name Rains & Williamson Oil Co., Inc.
City/State Wichita, Kansas 67202

Nearest lease or unit boundary line 330' feet.
County Pratt

Lease Name Carver Well# 1

Domestic well within 330 feet: yes no

Municipal well within one mile: yes no

Well Drilled For: Well Class: Type Equipment:
 Oil Swd Infield Mud Rotary
 Gas Inj Pool Ext. Air Rotary
 OWWO Expl Wildcat Cable

Depth to Bottom of fresh water 150' feet

Lowest usable water formation Top Permian

Depth to Bottom of usable water 250' feet

Surface pipe by Alternate: 1 2

Surface pipe to be set 350+ feet

Conductor pipe if any required No feet

Ground surface elevation 1994' feet MSL

This Authorization Expires 4-23-85

Approved By 10-23-84 *AC*

If OWWO: old well info as follows:

Operator
Well Name
Comp Date Old Total Depth
Projected Total Depth 4800' feet
Projected Formation at TD Simpson
Expected Producing Formations Viola

I certify that we will comply with K.S.A. 55-101, et seq., plus eventually plugging hole to K.C.C. specifications.

Date 10-23-84 Signature of Operator or Agent *W.C. Talbott*

Title

PRESIDENT


MHC/UDHE 10/23/84

Must be filed with the K.C.C. five (5) days prior to commencing well
 This card void if drilling not started within six (6) months of date received by K.C.C.
 KANSAS CONSERVATION DIVISION

OCT 23 1984
 10-23-84

Important procedures to follow :

A Regular Section of Land
 1 Mile = 5,280 Feet

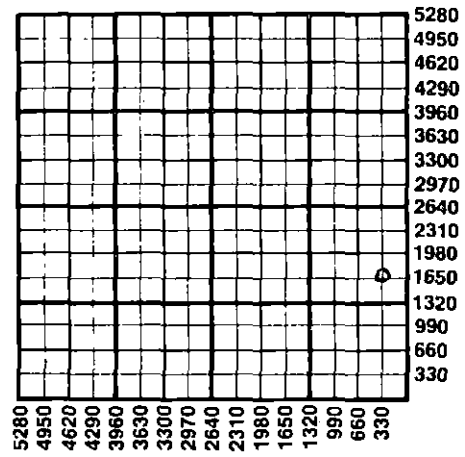

1. Notify District office before setting surface casing.
2. Set surface casing by circulating cement to the top.
3. File completion forms ACO-1 with K.C.C. within 90 days of well completion, following instructions on ACO-1, side 1, and including copies of wireline logs.
4. Notify District office 48 hours prior to old well workover or re-entry.
5. Prior to plugging, prepare a plugging plan, then obtain agreement from the appropriate district office for an approved plugging plan.
6. Submit plugging report (CP-4) to K.C.C. after plugging is completed.
7. Obtain an approved injection docket number before disposing of salt water.
8. Notify K.C.C. within 10 days when injection commences or terminates.
9. If an alternate 2 completion, cement in the production pipe from below any usable water to surface within 120 days of spud date.

State Corporation Commission of Kansas
Conservation Division
200 Colorado Derby Building
Wichita, Kansas 67202
(316) 263-3238