

CARD MUST BE TYPED

State of Kansas
NOTICE OF INTENTION TO DRILL
(see rules on reverse side)

CARD MUST BE SIGNED

Starting Date: July 15, 1985
month day year

API Number 15- 151-21644-00-00

OPERATOR: License # 5046
Name Raymond Oil Company, Inc.
Address One Main Place, #900
City/State/Zip Wichita, Kansas, 67202
Contact Person Pat Raymond
Phone (316) 267-4214

East
SE. SE. SE. Sec 7 Twp 29 S, Rge 15 West
(location)

330 Ft North from Southeast Corner of Section
330 Ft West from Southeast Corner of Section
(Note: Locate well on Section Plat on reverse side)

CONTRACTOR: License # 5829
Name Aldebaran Drilling Company, Inc.
City/State Wichita, Kansas

Nearest lease or unit boundary line 330 feet.
County Pratt

Lease Name House Well# 1

Domestic well within 330 feet: yes no
Municipal well within one mile: yes no

Well Drilled For: Well Class: Type Equipment:
 Oil Swd Infield Mud Rotary
 Gas Inj Pool Ext. Air Rotary
 OWWO Expl Wildcat Cable

Depth to Bottom of fresh water 180 feet
Lowest usable water formation Permian
Depth to Bottom of usable water 300 feet
Surface pipe by Alternate: 1 2

If OWWO: old well info as follows:

Operator
Well Name
Comp Date Old Total Depth
Projected Total Depth 4950 feet
Projected Formation at TD Arbuckle
Expected Producing Formations

Surface pipe to be set 350 feet
Conductor pipe if any required none feet
Ground surface elevation Est. 2060 feet MSI.
This Authorization Expires 1-2-86
Approved By Pat Raymond

I certify that we will comply with K.S.A. 55-101, et seq., plus eventually plugging hole to K.C.C. specifications.

RCM for KDFE

Date 7-1-85 Signature of Operator or Agent

Pat Raymond
Pat Raymond

Title Vice President


Must be filed with the K.C.C. five (5) days prior to commencing well
This card void if drilling not started within six (6) months of date received by K.C.C.

7-2-85

RECEIVED
STATE CORPORATION COMMISSION
JUL 02 1985
CONSERVATION DIVISION
Wichita, Kansas

Important procedures to follow

**A Regular Section of Land
1 Mile = 5,280 Ft.**

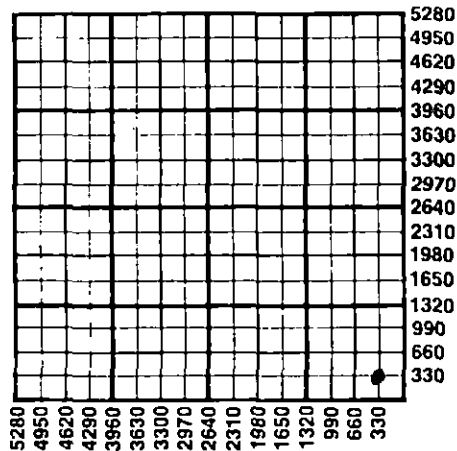

1. Notify District office before setting surface casing.
2. Set surface casing by circulating cement to the top.
3. File completion forms ACO-1 with K.C.C. within 90 days of well completion, following instructions on ACO-1, side and including copies of wireline logs.
4. Notify District office 48 hours prior to old well workover or re-entry.
5. Prior to plugging, prepare a plugging plan, then obtain agreement from the appropriate district office for an approved plugging plan.
6. Submit plugging report (CP-4) to K.C.C. after plugging is completed.
7. Obtain an approved injection docket number before disposing of salt water.
8. Notify K.C.C. within 10 days when injection commences or terminates.
9. If an alternate 2 completion, cement in the production pipe from below any usable water to surface within 120 days of spud date.

State Corporation Commission of Kansas
Conservation Division
200 Colorado Derby Building
Wichita, Kansas 67202
(316) 263-3238