

CARD MUST BE TYPED

State of Kansas
NOTICE OF INTENTION TO DRILL

CARD MUST BE SIGNED

(see rules on reverse side)

Starting Date: 11 28 84
month day year 10/10

API Number 15- 151-21,518-00-00

OPERATOR: License # 8059

E 1/2 SW SW Sec 4 Twp 29 S, Rge 15 East West
(location)

Name Robert-Gay Energy Enterprises, Inc.

Address 1006 N. Main

City/State/Zip Hutchinson, Kansas 67501

Contact Person Cheri Chance

Phone (316) 669-8164

680 Ft North from Southeast Corner of Section

4320 Ft West from Southeast Corner of Section

(Note: Locate well on Section Plat on reverse side)

CONTRACTOR: License # 8059

Nearest lease or unit boundary line 380 feet.

County Pratt

Lease Name Bolser Well# 7

Name Robert-Gay Energy Enterprises, Inc.

City/State Hutchinson, Kansas

Domestic well within 330 feet: yes no

Municipal well within one mile: yes no

Well Drilled For: Well Class: Type Equipment:

Oil Swd Infield Mud Rotary

Gas Inj Pool Ext. Air Rotary

OWWO Expl Wildcat Cable

Depth to Bottom of fresh water 200 feet

Lowest usable water formation

Depth to Bottom of usable water 300 feet

Surface pipe by Alternate: 1 2

Surface pipe to be set 300 feet

Conductor pipe if any required N/A feet

Ground surface elevation 2003 feet MSI.

This Authorization Expires 5-27-85

Approved By 11-27-84 [Signature]

If OWWO: old well info as follows:

Operator

Well Name

Comp Date Old Total Depth

Projected Total Depth 4600' feet

Projected Formation at TD

Expected Producing Formations

I certify that we will comply with K.S.A. 55-101, et seq., plus eventually plugging hole to K.C.C. specifications.

Date 11/26/84 Signature of Operator or Agent [Signature] Title

President

Must be filed with the K.C.C. five (5) days prior to commencing well
This card void if drilling not started within six (6) months of date received by K.C.C.

CONSERVATION DIVISION
WICHITA, KANSAS


NOV 27 1984

11-27-84

Important procedures to follow :

1. Notify District office before setting surface casing.
2. Set surface casing by circulating cement to the top.
3. File completion forms ACO-1 with K.C.C. within 90 days of well completion, following instructions on ACO-1, side 1, and including copies of wireline logs.
4. Notify District office 48 hours prior to old well workover or re-entry.
5. Prior to plugging, prepare a plugging plan, then obtain agreement from the appropriate district office for an approved plugging plan.
6. Submit plugging report (CP-4) to K.C.C. after plugging is completed.
7. Obtain an approved injection docket number before disposing of salt water.
8. Notify K.C.C. within 10 days when injection commences or terminates.
9. If an alternate 2 completion, cement in the production pipe from below any usable water to surface within 120 days of spud date.

State Corporation Commission
A Regulated Utility
1000 East 10th St.
Topeka, Kansas 66603

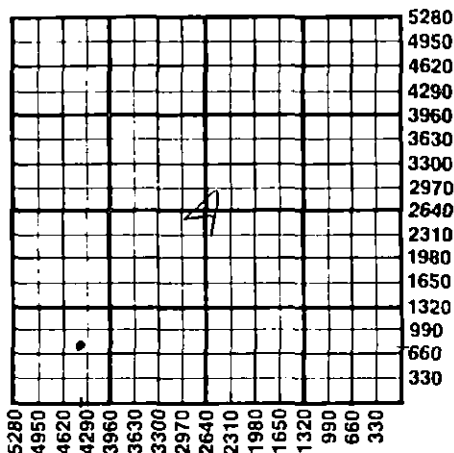

State Corporation Commission of Kansas
Conservation Division
200 Colorado Derby Building
Wichita, Kansas 67202
(316) 263-3238