

CARD MUST BE TYPED

State of Kansas  
**NOTICE OF INTENTION TO DRILL**

CARD MUST BE SIGNED

(see rules on reverse side)

Starting Date: 12-08-84  
month day year 3:55

API Number 15- 151-21,529-00-00

OPERATOR: License # 8059  
Name Robert-Gay Energy Enterprises, Inc.

E 1/2 W 1/2 SW Sec 4 Twp 29 S, Rge 15  
(location)  East  West

Address 1006 N. Main

City/State/Zip Hutchinson, KS 67501

Contact Person Robert L. Taylor

Phone (316) 669-8164

CONTRACTOR: License # 8059

Name Robert-Gay Energy Enterprises, Inc.

City/State Hutchinson, KS

Well Drilled For: Well Class: Type Equipment:

- Oil  Swd  Infield  Mud Rotary
- Gas  Inj  Pool Ext.  Air Rotary
- OWWO  Expl  Wildcat  Cable

If OWWO: old well info as follows:

Operator .....

Well Name .....

Comp Date ..... Old Total Depth .....

Projected Total Depth ..... 4900 feet

Projected Formation at TD .....

Expected Producing Formations .....

I certify that we will comply with K.S.A. 55-101, et seq., plus eventually plugging hole to K.C.C. specifications.

Date 12-07-84 Signature of Operator or Agent

*Robert L. Taylor*

President

MHC/KOHE 12/7/84

1340 Ft North from Southeast Corner of Section

4320 Ft West from Southeast Corner of Section  
(Note: Locate well on Section Plat on reverse side)

Nearest lease or unit boundary line ..... 380 feet.

County Pratt

Lease Name Bolser Well# 8

Domestic well within 330 feet:  yes  no

Municipal well within one mile:  yes  no

Depth to Bottom of fresh water ..... 200 feet

Lowest usable water formation .....

Depth to Bottom of usable water ..... 300 feet

Surface pipe by Alternate: 1  2

Surface pipe to be set ..... 300 feet

Conductor pipe if any required ..... N/A feet

Ground surface elevation ..... feet MSL

This Authorization Expires 6-7-85


Approved By 12-7-84 *R*

RECEIVED  
STATE CORPORATION COMMISSION

Must be filed with the K.C.C. five (5) days prior to commencing well  
This card void if drilling not started within six (6) months of date received by K.C.C.

DEC 07 1984 12-7-84

CONSERVATION DIVISION  
Wichita, Kansas  
**A Regular Section of Land**  
1 Mile = 5,280 Ft.

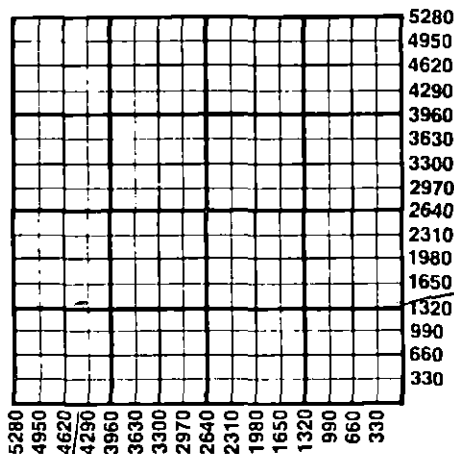

**Important procedures to follow :**

1. Notify District office before setting surface casing.
2. Set surface casing by circulating cement to the top.
3. File completion forms ACO-1 with K.C.C. within 90 days of well completion, following instructions on ACO-1, side 1, and including copies of wireline logs.
4. Notify District office 48 hours prior to old well workover or re-entry.
5. Prior to plugging, prepare a plugging plan, then obtain agreement from the appropriate district office for an approved plugging plan.
6. Submit plugging report (CP-4) to K.C.C. after plugging is completed.
7. Obtain an approved injection docket number before disposing of salt water.
8. Notify K.C.C. within 10 days when injection commences or terminates.
9. If an alternate 2 completion, cement in the production pipe from below any usable water to surface within 120 days of spud date.

State Corporation Commission of Kansas  
Conservation Division  
200 Colorado Derby Building  
Wichita, Kansas 67202  
(316) 263-3238