

CARD MUST BE TYPED

State of Kansas
NOTICE OF INTENTION TO DRILL

CARD MUST BE SIGNED

(see rules on reverse side)

Starting Date: 10 20 84
month day year 3:10

API Number 15- 151-21,503-00-00

OPERATOR: License # 8059

~~NW 1/4~~ ~~SW 1/4~~ ~~SE 1/4~~ Sec 4... Twp 29. S, Rge 15. East West
(location)

Name Robert-Gay Energy Enterprises, Inc.

Address 1006 N. Main

City/State/Zip Hutchinson, KS 67051

Contact Person Robert L. Taylor

Phone (316) 669-8164

3460..... Ft North from Southeast Corner of Section

4840..... Ft West from Southeast Corner of Section

(Note: Locate well on Section Plat on reverse side)

CONTRACTOR: License # 8059

Name Robert-Gay Energy Enterprises, Inc.

City/State Hutchinson, KS 67051

Nearest lease or unit boundary line 430..... feet.

County Pratt

Lease Name Bolser Well# 5

Domestic well within 330 feet: yes no

Municipal well within one mile: yes no

Well Drilled For: Well Class: Type Equipment:

Oil Swd Infield Mud Rotary

Gas Inj Pool Ext. Air Rotary

OWWO Expl Wildcat Cable

Depth to Bottom of fresh water 200..... feet

Lowest usable water formation

Depth to Bottom of usable water 300..... feet

Surface pipe by Alternate: 1 2

Surface pipe to be set 300..... feet

Conductor pipe if any required None..... feet

Ground surface elevation 2001..... feet MSI.

This Authorization Expires 4-19-85

Approved By 10-19-84 *R*

If OWWO: old well info as follows:

Operator

Well Name

Comp Date Old Total Depth

Projected Total Depth 4700..... feet

Projected Formation at TD Arbuckle.....

Expected Producing Formations

I certify that we will comply with K.S.A. 55-101, et seq., plus eventually plugging hole to K.C.C. specifications.

Date 10/19/84 Signature of Operator or Agent


Robert L. Taylor President
Title
MHC/UCOHE 10/19/84

Must be filed with the K.C.C. five (5) days prior to commencing well
 This card void if drilling not started within six (6) months of date received by K.C.C.

Important procedures to follow :

**A Regular Section of Land
 1 Mile = 5,280 Ft.**

1. Notify District office before setting surface casing.
2. Set surface casing by circulating cement to the top.
3. File completion forms ACO-1 with K.C.C. within 90 days of well completion, following instructions on ACO-1, side 1, and including copies of wireline logs.
4. Notify District office 48 hours prior to old well workover or re-entry.
5. Prior to plugging, prepare a plugging plan, then obtain agreement from the appropriate district office for an approved plugging plan.
6. *Submit plugging report (CP-4) to K.C.C. after plugging is completed.*
7. Obtain an approved injection docket number before disposing of salt water.
8. Notify K.C.C. within 10 days when injection commences or terminates.
9. If an alternate 2 completion, cement in the production pipe from below any usable water to surface within 120 days of spud date.

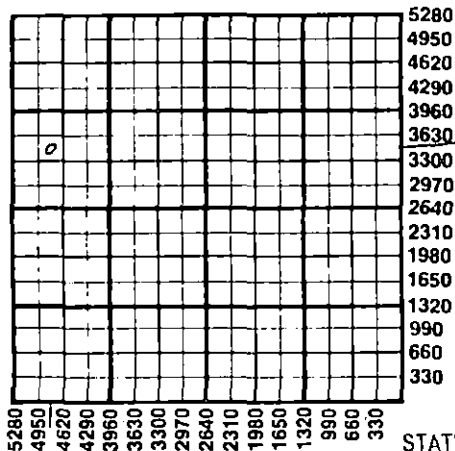

RECEIVED

STATE CORPORATION COMMISSION

State Corporation Commission of Kansas
 Conservation Division
 200 Colorado Derby Building
 Wichita, Kansas 67202
 (316) 263-3238

10-19-84

OCT 19 1984

Wichita, Kansas