

CARD MUST BE TYPED

State of Kansas
NOTICE OF INTENTION TO DRILL
(see rules on reverse side)

CARD MUST BE SIGNED

Starting Date: January 23, 1985
month day year

API Number 15-151-21,566-00-00

OPERATOR: License # 5171
Name TXO Production Corp.
Address 200 W. Douglas Ste. 300
City/State/Zip Wichita, Kansas 67202
Contact Person Gary Wurdeman
Phone (316) 265-9441

NW NW NE 9 Sec 29S Twp 15W East
(location) West

4950' Ft North from Southeast Corner of Section
2310' Ft West from Southeast Corner of Section
(Note: Locate well on Section Plat on reverse side)

CONTRACTOR: License # 6165
Name FWA Drilling Co., Inc.
City/State Yukon, Oklahoma 73085-0980

Nearest lease or unit boundary line 330' feet.
County Pratt
Lease Name Bryant 'C' Well# #1

Well Drilled For: Well Class: Type Equipment:
 Oil Swd Infield Mud Rotary
 Gas Inj Pool Ext. Air Rotary
 OWWO Expl Wildcat Cable

Domestic well within 330 feet: yes no
Municipal well within one mile: yes no

If OWWO: old well info as follows:

Depth to Bottom of fresh water 100' 200' mhc feet
Lowest usable water formation Holdridge
Depth to Bottom of usable water 300' feet
Surface pipe by Alternate: 1 2
Surface pipe to be set 350 feet
Conductor pipe if any required _____ feet
Ground surface elevation TBD feet MSL
This Authorization Expires 7-18-85
Approved By RCA/KCC 1-18-85

Operator _____
Well Name _____
Comp Date _____ Old Total Depth _____
Projected Total Depth 4800' feet
Projected Formation at TD Simpson
Expected Producing Formations Simpson

I certify that we will comply with K.S.A. 55-101, et seq., plus eventually plugging hole to K.C.C. specifications.


Date 1-17-85 Signature of Operator or Agent Jerry W. Collins Title Drilling & Completion Engr.

mhc/LOHE 1-18-85
Form C-1 4/84

Must be filed with the K.C.C. five (5) days prior to commencing well
 This card void if drilling not started within six (6) months of date received by K.C.C.
 CONSERVATION DIVISION
 Wichita, Kansas

8661 8 NVAI JAN 7 8 1985 1-18-85

NOISSIWIWNS M...
 A Regular Section of Land
 1 M... 3280 Ft.

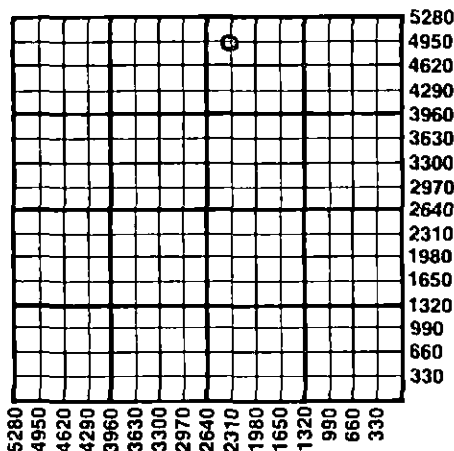

Important procedures to follow :

1. Notify District office before setting surface casing.
2. Set surface casing by circulating cement to the top.
3. File completion forms ACO-1 with K.C.C. within 90 days of well completion, following instructions on ACO-1, side 1, and including copies of wireline logs.
4. Notify District office 48 hours prior to old well workover or re-entry.
5. Prior to plugging, prepare a plugging plan, then obtain agreement from the appropriate district office for an approved plugging plan.
6. Submit plugging report (CP-4) to K.C.C. after plugging is completed.
7. Obtain an approved injection docket number before disposing of salt water.
8. Notify K.C.C. within 10 days when injection commences or terminates.
9. If an alternate 2 completion, cement in the production pipe from below any usable water to surface within 120 days of spud date.

**State Corporation Commission of Kansas
 Conservation Division
 200 Colorado Derby Building
 Wichita, Kansas 67202
 (316) 263-3238**