

CARD MUST BE TYPED

State of Kansas  
**NOTICE OF INTENTION TO DRILL**  
(see rules on reverse side)

*Collection*  
CARD MUST BE SIGNED

**\*\*CORRECTION\*\***

5-29-85

Starting Date: May 30 1985  
month day year

API Number 15- 151-21, 599-00-00

OPERATOR: License # 5171  
Name TXO Production Corp.  
Address 200 W. Douglas, Suite 300  
City/State/Zip Wichita, KS 67202  
Contact Person Jerry W. Collins  
Phone 316-265-9441

\* SW, NW, NW (location) Sec 9, Twp 29, S, Rge 15.  East  West

\* 4290 Ft North from Southeast Corner of Section  
\* 4950 Ft West from Southeast Corner of Section  
(Note: Locate well on Section Plat on reverse side)

CONTRACTOR: License # 6165  
Name FWA Drilling Co. Inc.  
City/State Yukon, OK 73085

Nearest lease or unit boundary line 330 feet.  
County Pratt  
Lease Name BRYANT C Well# 5

Well Drilled For: Well Class: Type Equipment:  
 Oil  Swd  Infield  Mud Rotary  
 Gas  Inj  Pool Ext.  Air Rotary  
 OWWO  Expl  Wildcat  Cable

Domestic well within 330 feet:  yes  no  
Municipal well within one mile:  yes  no

If OWWO: old well info as follows:  
Operator  
Well Name  
Comp Date Old Total Depth  
Projected Total Depth 4800 feet  
Projected Formation at TD Viola  
Expected Producing Formations Viola

Depth to Bottom of fresh water 100 feet  
Lowest usable water formation Holdridge  
Depth to Bottom of usable water 250 feet  
Surface pipe by Alternate: 1  2   
Surface pipe to be set 350 feet  
Conductor pipe if any required 0 feet  
Ground surface elevation TBD feet MSL  
This Authorization Expires 10-4-85  
Approved By 9-4-85

I certify that we will comply with K.S.A. 55-101, et seq., plus eventually plugging hole to K.C.C. specifications. *to as SESW 2970 FSL*

Date 5-29-85 Signature of Operator or Agent *Jerry W. Collins* Title Drlg & Completion Engr *4290 FEL*  
Form C-1 4/84


RECEIVED  
STATE CORPORATION COMMISSION

Must be filed with the K.C.C. five (5) days prior to commencing well  
This card void if drilling not started within six (6) months of date received by K.C.C.

MAY 29 1985

5-29-85

CONSERVATION DIVISION  
A Regular Section of Land  
1 Mile 5,280 Ft.

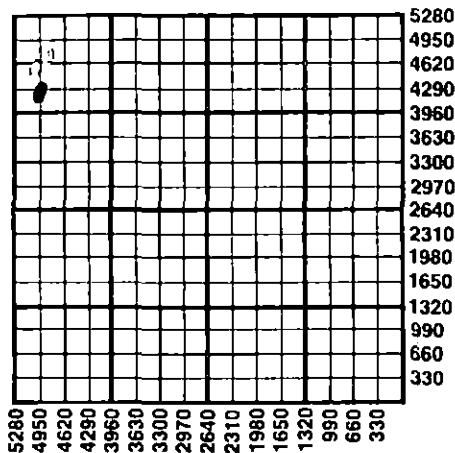

**Important procedures to follow:**

1. Notify District office before setting surface casing.
2. Set surface casing by circulating cement to the top.
3. File completion forms ACO-1 with K.C.C. within 90 days of well completion, following instructions on ACO-1, side 1, and including copies of wireline logs.
4. Notify District office 48 hours prior to old well workover or re-entry.
5. Prior to plugging, prepare a plugging plan, then obtain agreement from the appropriate district office for an approved plugging plan.
6. Submit plugging report (CP-4) to K.C.C. after plugging is completed.
7. Obtain an approved injection docket number before disposing of salt water.
8. Notify K.C.C. within 10 days when injection commences or terminates.
9. If an alternate 2 completion, cement in the production pipe from below any usable water to surface within 120 days of spud date.

State Corporation Commission of Kansas  
Conservation Division  
200 Colorado Derby Building  
Wichita, Kansas 67202  
(316) 263-3238