

STATE CORPORATION COMMISSION OF KANSAS  
OIL & GAS CONSERVATION DIVISION

WELL COMPLETION OR RECOMPLETION FORM  
ACO-1 WELL HISTORY

DESCRIPTION OF WELL AND LEASE

Operator: license # 5046  
name Raymond Oil Company, Inc.  
address One Main Place  
Suite 900  
City/State/Zip Wichita, Kansas 67202

Operator Contact Person Pat Raymond  
Phone 316/267-4214

Contractor: license # 5829  
name Aldebaran Drilling Company

Wellsite Geologist Richard E. Rowland  
Phone 316/722-1067

PURCHASER

Designate Type of Completion  
 New Well  Re-Entry  Workover

- Oil  SWD  Temp Abd
- Gas  Inj  Delayed Comp.
- Dry  Other (Core, Water Supply etc.)

If OWWO: old well info as follows:  
Operator  
Well Name  
Comp. Date Old Total Depth

WELL HISTORY

Drilling Method:  Mud Rotary  Air Rotary  Cable

9-9-85 9-18-85 9-18-85  
Spud Date Date Reached TD Completion Date

4900' PBDT  
Total Depth

Amount of Surface Pipe Set and Cemented at 387' feet

Multiple Stage Cementing Collar Used?  Yes  No

If Yes, Show Depth Set feet

If alternate 2 completion, cement circulated from feet depth to w/ SX cmt

API NO. 15-151-21,644-00-00

County Pratt

SE... SE... SE. Sec. 7... Twp 29S... Rge. 15... W. K

330 Ft North from Southeast Corner of Secti

330 Ft West from Southeast Corner of Secti

(Note: locate well in section plat below)


Lease Name House Well# 1

Field Name Northcroft

Producing Formation

Elevation: Ground 2058' KB 2065'

Section Plat

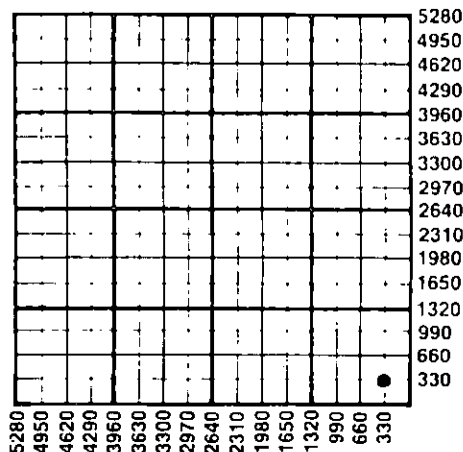

WATER SUPPLY INFORMATION

Source of Water:

Division of Water Resources Permit #

approx. 330 Ft North From Southeast Corner ar  
 Groundwater (Well) 330 Ft. West From Southeast Corner  
Sec 7 Twp 29SRge 15  East  West

Surface Water Ft North From Southeast Corner ar  
(Stream, Pond etc.) Ft West From Southeast Corn.  
Sec Twp Rge  East  West

Other (explain) (purchased from city, R.W.D.#)

Disposition of Produced Water:  Disposal  Repressuring

Docket #

INSTRUCTIONS: This form shall be completed in duplicate and filed with the Kansas Corporation Commission, 200 Colorado Derby Building, Wichita, Kansas 67202, within 90 days after completion or recompletion of any well. Rules 82-3-130 and 82-3-107 apply.

Information on side two of this form will be held confidential for a period of 12 months if requested in writing and submitted with the form. See rule 82-3-107 for confidentiality in excess of 12 months.

One copy of all wireline logs and drillers time log shall be attached with this form. Submit CP-4 form with all plugged wells. Submit CP-111 form with all temporarily abandoned wells.

All requirements of the statutes, rules, and regulations promulgated to regulate the oil and gas industry have been fully complied with and the statements herein are complete and correct to the best of my knowledge.

Signature Wm. M. Raymond  
Title President Date 10-2-85

Subscribed and sworn to before me this 2nd day of October 19 85

Notary Public Shirley Wilkie, Shirley Wilkie  
Date Commission Expires 1-29-88

K.C.C. OFFICE USE ONLY

- Letter of Confidentiality Attached
- Wireline Log Received
- Drillers Timelog Received

Distribution

- KCC
- KGS
- SWD/Rep
- Plug
- NGPA
- Other (Specify)

RECEIVED  
STATE CORPORATION COMMISSION

OCT 3 1985 Form ACO-1 (7-84) 10-3-85