

STATE CORPORATION COMMISSION OF KANSAS
OIL & GAS CONSERVATION DIVISION

WELL COMPLETION OR RECOMPLETION FORM
ACO-1 WELL HISTORY

DESCRIPTION OF WELL AND LEASE

Operator: License # 8059
Name Robert-Gay Energy Enterprises, Inc.
Address 1006 North Main
City/State/Zip Hutchinson, Ks 67501

Purchaser Inland Crude Purchasing

Operator Contact Person Robert L. Taylor
Phone 316-669-8164

Contractor: License # 8059
Name Robert-Gay Energy

Wellsite Geologist E.G. Lorenz
Phone 316-683-2832

Designate Type of Completion
 New Well Re-Entry Workover
 Oil SWD Temp Abd
 Gas Inj Delayed Comp.
 Dry Other (Core, Water Supply etc.)

If OWN: old well info as follows:
Operator
Well Name
Comp. Date Old Total Depth

WELL HISTORY

Drilling Method:
 Mud Rotary Air Rotary Cable
10-10-84 10-19-84 12-5-84
Spud Date Date Reached TD Completion Date
4880
Total Depth PBT

Amount of Surface Pipe Set and Cemented at 431 feet
Multiple Stage Cementing Collar Used? Yes No
if yes, show depth set feet
if alternate 2 completion, cement circulated from feet depth to w/SX cmt


API NO. 15-151-21,494-00-00
County Pratt
Sec 4 Twp 29 Rge 15 East West

3000 Ft North from Southeast Corner of Section
4650 Ft West from Southeast Corner of Section
(Note: Locate well in section plat below)

Lease Name Bolser Well # 4 "RG"
Field Name ~~Unknown~~ Unknown Springvale, N.W.

Producing Formation Simpson

Elevation: Ground 1997 KB 2005
Section Plat

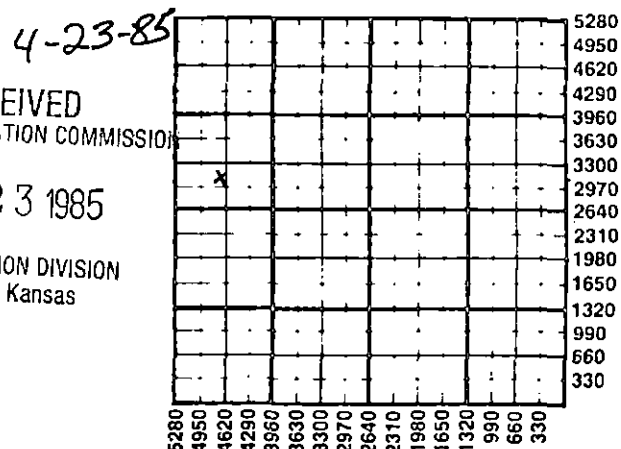

WATER SUPPLY INFORMATION
Disposition of Produced Water: Disposal Repressuring
Docket #

Questions on this portion of the ACO-1 call:
Water Resources Board (913) 296-3717

Source of Water:
Division of Water Resources Permit #
 Groundwater Ft North from Southeast Corner (Well) Ft West from Southeast Corner of Sec Twp Rge East West
 Surface Water Ft North from Southeast Corner (Stream, pond etc) Ft West from Southeast Corner Sec Twp Rge East West
 Other (explain) (purchased from city, R.W.D. #)

INSTRUCTIONS: This form shall be completed in duplicate and filed with the Kansas Corporation Commission, 200 Colorado Derby Building, Wichita, Kansas 67202, within 90 days after completion or recompletion of any well. Rule 82-3-130 and 82-3-107 apply. Information on side two of this form will be held confidential for a period of 12 months if requested in writing and submitted with the form. See rule 82-3-107 for confidentiality in excess of 12 months. One copy of all wireline logs and drillers time log shall be attached with this form. Submit CP-4 form with all plugged wells. Submit CP-111 form with all temporarily abandoned wells.

All requirements of the statutes, rules and regulations promulgated to regulate the oil and gas industry have been fully complied with and the statements herein are complete and correct to the best of my knowledge.

Signature Robert L. Taylor
Title President Date 4-19-85

Subscribed and sworn to before me this 19th day of April 1985
Notary Public Cheryl A. Chance

Date Commission Expires 6-6-87

K.C.C. OFFICE USE ONLY
F Letter of Confidentiality Attached
C Wireline Log Received
C Drillers Timelog Received
Distribution
 KCC SWD/Rep NGPA
 KGS Plug Other (Specify)

Sec 4 Twp 29 Rge 15

SIDE TWO

Operator Name Robert-Gay Energy Lease Name Bolser Well # 4 "RG"

Sec. 4 Twp. 29S Rge. 15W East West County Pratt

WELL LOG

INSTRUCTIONS: Show important tops and base of formations penetrated. Detail all cores. Report all drill stem tests giving interval tested, time tool open and closed, flowing and shut-in pressures, whether shut-in pressure reached static level, hydrostatic pressures, bottom hole temperature, fluid recovery, and flow rates if gas to surface during test. Attach extra sheet if more space is needed. Attach copy of log.

Drill Stem Tests Taken Yes No
 Samples Sent to Geological Survey Yes No
 Cores Taken Yes No

Formation Description
 Log Sample

Name	Top	Bottom
Heebner Shale	3876	(-1871)
Lansing Kansas City	4054	(-2049)
Base Kansas City	4380	(-2375)
Marmaton	4389	(-2384)
Cherokee	4528	(-2523)
Souey Congl.	4550	(-2545)
Mississippi	4578	(-2573)
Viola	4656	(-2651)
Simpson	4738	(-2733)
Arbuckle	4808	(-2803)

CASING RECORD New Used
 Report all strings set-conductor, surface, intermediate, production, etc.

Purpose of String	Size Hole Drilled	Size Casing Set (In O.D.)	Weight Lbs/Ft.	Setting Depth	Type of Cement	#Sacks Used	Type and Percent Additives
Surface		8 5/8	24 lb.	431'	60/40 Poz	300	3% cc 2% gel
Casing	7 7/8	5 1/2	14 lb.	4878	60/40 Poz	350	2% gel

PERFORATION RECORD **Acid, Fracture, Shot, Cement Squeeze Record**
 Shots Per Foot Specify Footage of Each Interval Perforated (Amount and Kind of Material Used) Depth

4	4738-4750	15% MCA, 300 gal.	4738-4750
		Ottawa frac sand 20-40 60 sks	4738-4750
		Brady frac sand 10-20 50 sks	4738-4750

TUBING RECORD Size Set At Packer at Liner Run Yes No

Date of First Production 12-3-84 Producing Method Flowing Pumping Gas Lift Other (explain.....)

Estimated Production Per 24 Hours	Oil Bbls	Gas MCF	Water Bbls	Gas-Oil Ratio	Gravity
	20	enough to run engine & heater	10%		36

METHOD OF COMPLETION

Production Interval

Disposition of gas: Vented Open Hole Perforation
 Sold Other (Specify)
 Used on Lease Dually Completed
 Commingled