


STATE OF KANSAS
STATE CORPORATION COMMISSION

WELL PLUGGING RECORD

Give All Information Completely
Make Required Affidavit
Mail or Deliver Report to
Conservation Division
State Corporation Comm.
245 North Water
Wichita, KS 67202

Stafford County. Sec. 21 Twp. 24 Rge. 11 E/W
Location as "NE/CNW 1/4 SW 1/4" or footage from lines _____
NW SE SE
Lease Owner Fell & Wolfe
Lease Name Fuller Well No. One
Office Address P. O. Box 7447 Tulsa, Oklahoma
Character of Well (Completed as Oil, Gas or Dry Hole) _____

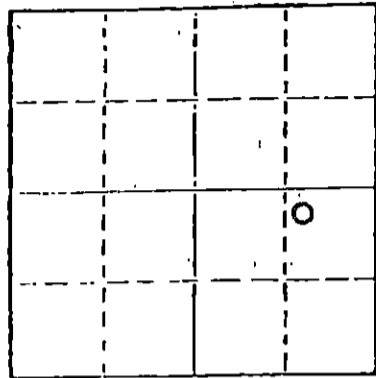

Dry Hole
Date Well completed _____ 1977
Application for plugging filed 6-21 1977
Application for plugging approved 6-21 1977
Plugging commenced 6-21 1977
Plugging completed 6-21 1977
Reason for abandonment of well or producing formation _____

Dry Hole
If a producing well is abandoned, date of last production _____ 19____

Was permission obtained from the Conservation Division or its agents before plugging was commenced? Yes

Name of Conservation Agent who supervised plugging of this well Jasper H. Metz
Producing formation None Depth to top _____ Bottom _____ Total Depth of Well 3845
Show depth and thickness of all water, oil and gas formations.

OIL, GAS OR WATER RECORDS

CASING RECORD

FORMATION	CONTENT	FROM	TO	SIZE	PUT IN	PULLED OUT
				8 5/8	227	None

Describe in detail the manner in which the well was plugged, indicating where the mud fluid was placed and the method or methods used in introducing it into the hold. If cement or other plugs were used, state the character of same and depth placed, from _____ feet to _____ feet for each plug set.

Plug @ 40 w/ 1/2 Sk hulls 12 sks cement
Plug @ 200' w/ 40 Sks Cement
Mud 200' to 3,845
3 sks in rat hole

RECEIVED
JUN 28 1977 6-28-77

(If additional description is necessary, use BACK of this sheet)

Name of Plugging Contractor Big Springs Drilling, Inc.

STATE OF Kansas COUNTY OF Sedgwick, ss.
Paul A. Seymour, Jr. (employee of owner) or (owner or operator)
of the above-described well, being first duly sworn on oath, says: That I have knowledge of the facts, statements, and matters herein contained and the log of the above-described well as filed and that the same are true and correct. So help me God.

(Signature) Paul A. Seymour Jr.
P. O. Box 8267 Munger Station
(Address) Wichita, Kansas

SUBSCRIBED AND SWORN TO before me this 27th day of June, 19 77

Ruth M. Bassett
Ruth M. Bassett Notary Public.

My commission expires May 30, 1979

15-185-20738-0000

BIG SPRINGS DRILLING, INC.

P.O. BOX 8287
MUNGER STATION
WICHITA, KANSAS 67208

SUITE 29 • 400 NORTH WOODLAWN • (316) 681-1732

June 27, 1977

DRILLERS LOG

#1 Fullor
NW SE SE
Sec. 21 -24 -11
Stafford Co., Kansas

OPERATOR: Fell & Wolfe Oil Company
CONTRACTOR: Big Springs Drilling, Inc.
COMMENCED: 5-14-77
COMPLETED: 5-21-77

2 5/8" @ 227' w 200 sks
6-28-77

0	227	Surface Clay & Sand
227	200	Shale & Red Beds
000	2751	Shale & Lime
2751	3695	Lime & Shale
3695	3740	Lime & Chert
3740	3836	Shale & Lime
3836	3845	Sand
3845		RTD

RECEIVED
STATE CORPORATION COMMISSION

JUN 28 1977

CONSERVATION DIVISION
Wichita, Kansas

D & A


we certify that the above and foregoing is a true and correct copy of the log on the Fullor #1 located in Stafford County, Ks.

BIG SPRINGS DRILLING, INC.

Paul A. Seymour, Jr.
Paul A. Seymour, Jr.

Subscribed and sworn to before me on this 27th day of June, 1977

My commission Expires: May 30, 1978

 

Ruth M. Bassett
Notary Public Ruth M. Bassett