

STATE OF KANSAS
STATE CORPORATION COMMISSION


Form CP-4

Give All Information Completely
Make Required Affidavit
Mail or Deliver Report to:
Conservation Division
State Corporation Commission

WELL PLUGGING RECORD

P. O. Box 17027
Wichita, Kansas 67217
NORTH

Stafford County, Sec. 21, Twp. 24S, Rge. (E) 11 (W)
Location as "NE/CNW/SW" or footage from lines SW SE NE
Lease Owner Parrish Oil Company
Lease Name McComb Well No. 2
Office Address 714 Fourth National Bank Bldg., Wichita, Kansas
Character of Well (completed as Oil, Gas or Dry Hole) oil 67202
Date well completed _____ 19____
Application for plugging filed October 8 19 74
Application for plugging approved _____ 19____
Plugging commenced October 10 19 74
Plugging completed October 14 19 74
Reason for abandonment of well or producing formation depleted

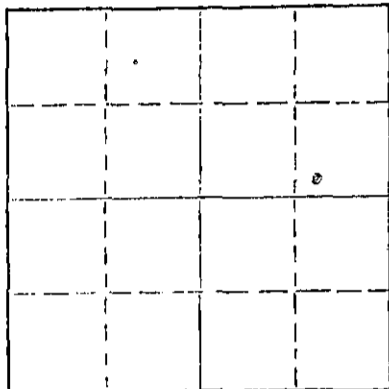

Locate well correctly on above
Section Plat

If a producing well is abandoned, date of last production _____ 19____
Was permission obtained from the Conservation Division or its agents before plugging was commenced? yes

Name of Conservation Agent who supervised plugging of this well G. R. Biberstein
Producing formation _____ Depth to top _____ Bottom _____ Total Depth of Well 3835 Feet
Show depth and thickness of all water, oil and gas formations.

OIL, GAS OR WATER RECORDS

CASING RECORD

FORMATION	CONTENT	FROM	TO	SIZE	PUT IN	PULLED OUT
			213'	8 5/8"	213'	none
			3833'	5 1/2"	3833'	3107.24

Describe in detail the manner in which the well was plugged, indicating where the mud fluid was placed and the method or methods used in introducing it into the hole. If cement or other plugs were used, state the character of same and depth placed, from _____ feet to _____ feet for each plug set.

Sanded back to 3300' and dumped 5 sacks of cement.
Halliburton plugged well pumping in 3 sacks of hulls, 10 sacks of gel and 100 sacks of cement.

RECEIVED
10-17-74
STATE CORPORATION COMMISSION
OCT 17 1974
CONSERVATION DIVISION
Wichita, Kansas

Name of Plugging Contractor PIPE PULLERS, INC.
Address Box 128, Ellinwood, Kansas 67526

STATE OF KANSAS, COUNTY OF BARTON, ss.
Evelyn Roth (employee of owner) or (owner or operator) of the above-described well, being first duly sworn on oath, says: That I have knowledge of the facts, statements, and matters herein contained and the log of the above-described well as filed and that the same are true and correct. So help me God.

(Signature) Evelyn Roth
Ellinwood, Kansas (Address)

SUBSCRIBED AND SWORN to before me this 15th day of October, 19 74

JENNY KASSELMAN
NOTARY PUBLIC
BARTON COUNTY, KANSAS
MY COMM. EXP. JULY 16, 1978

My commission expires _____

Jenny Kaselman
Notary Public.


WELL LOG BUREAU--KANSAS GEOLOGICAL SOCIETY
508 East Murdock, Wichita, Kansas

Company- ANSCHUTZ DRILLING CO. INC.
Farm- McComb No: 2

SEC. 21 T. 24 R. 11W
SW NE NE
SW SE NE

Total Depth. 3837
Comm. 10-20-51 Comp. 11-4-51
Shot or Treated.
Contractor. Buick Drlg. Co.
Issued. 10-4-52

County Stafford
KANSAS

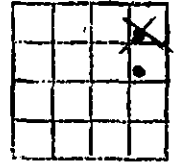

Elevation. 1827 DE

Production. Pmp. 85 BO & 11 BW

Figures indicate Bottom of Formations.

sand & shells	145
shale & shells	213
shale	235
red bed & shale	575
anhydrite, lime	605
shale & shells	1120
shale & salt	1250
shale & shells	1615
lime	1750
lime & shale	1985
lime brkn	2195
lime & shale	2375
shale	2535
shale & lime	2791
lime broken	3032
shale	3062
lime broken	3115
shale & lime	3205
lime broken	3240
lime & shale	3431
lime	3720
shale	3723
lime & shale	3750
shale	3812
shale & chert	3832 RTD
shale & chert	3837
Total Depth	

Scout Tops:	
Hoebner	3246
Brown Lime	3410
Lansing	3431
Viola Chert	3822
Dolomite	3832

10-10-74
RECEIVED
STATE CORPORATION COMMISSION
OCT 10 1974
CONSERVATION DIVISION
Wichita, Kansas