

STATE OF KANSAS  
STATE CORPORATION COMMISSION

WELL PLUGGING RECORD

Give All Information Completely  
Make Required Affidavit  
Mail or Deliver Report to:  
Conservation Division  
State Corporation Commission  
800 Bitting Building  
Wichita, Kansas

Stafford County, Sec. 19 Twp. 24 Rge. 11 (E) W (W)

Location as "NE/CNW/SW" or footage from lines NW NW SW

Lease Owner Harms-Burt Drilling Co.

Lease Name Allen Well No. 1

Office Address Box 184, Great Bend, Kans.

Character of Well (completed as Oil, Gas or Dry Hole) Dry Hole

Date well completed December 10 19 54

Application for plugging filed December 10 19 54

Application for plugging approved December 10 (orally) 19 54

Plugging commenced December 10 19 54


Plugging completed December 10 19 54

Reason for abandonment of well or producing formation

If a producing well is abandoned, date of last production 19

Was permission obtained from the Conservation Division or its agents before plugging was commenced? yes

NORTH

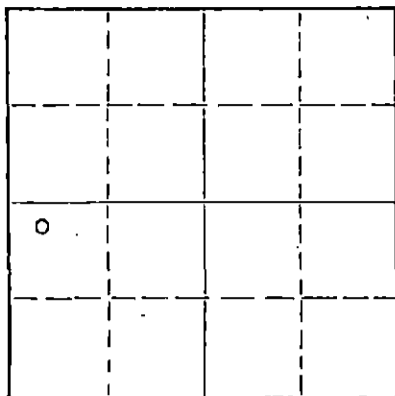

Locate well correctly on above Section Plat

Name of Conservation Agent who supervised plugging of this well M.A. Rives, Box 8, Pratt, Kans.

Producing formation Depth to top Bottom Total Depth of Well 4109 Feet

Show depth and thickness of all water, oil and gas formations.

OIL, GAS OR WATER RECORDS

CASING RECORD

FORMATION	CONTENT	FROM	TO	SIZE	PUT IN	PULLED OUT
Surface		0'	210'	8 5/8"	210'	0

Describe in detail the manner in which the well was plugged, indicating where the mud fluid was placed and the method or methods used in introducing it into the hole. If cement or other plugs were used, state the character of same and depth placed, from feet to feet for each plug set.

Filled hole with mud from 4109 to 210'  
Set plug at 210' with 20 sacks cement on top.  
Filled with heavy mud to 35' with plug set at 35'  
10 sacks cement on top of plug.

(If additional description is necessary, use BACK of this sheet)

Name of Plugging Contractor Harms-Burt Drilling Co.

Address Box 184, Great Bend, Kans.

STATE OF Kansas COUNTY OF Barton ss.  
Allan Harms (employee of owner) or (owner or operator) of the above-described

well, being first duly sworn on oath, says: That I have knowledge of the facts, statements, and matters herein contained and the log of the above-described well as filed and that the same are true and correct. So help me God.

(Signature) Allan Harms

Box 184, Great Bend, Kans.

(Address)

SUBSCRIBED AND SWORN to before me this 23 day of December, 19 54

Mary E Van Pelt

Notary Public.

My commission expires 1-20-58

12-24-54

PLUGGING  
FILED SEC 19 TWP 24 R 11W  
BOOK PAGE 23 LINE 44

Driller's Log

Company: Harms-Burt Drilling Co.

NW NW SW Sec. 19-24-11W  
Stafford County, Kansas

Farm: Allen No. 1

Commenced: November 27, 1954 Completed: December 10, 1954

Elevation: 1842 KB

0- 40	Surface clay & sand	3030-3150	Lime and shale
40- 120	Sand	3150-3215	Lime
120- 210	Shale & shells	3215-3445	Lime and shale
210- 370	Red bed, shale & shells	3445-3472	Sand and shale
370- 405	Red bed and sand	3472-3815	Lime
405- 612	Red bed and shells	3815-3875	Lime and shale
612- 630	Anhydrite	3875-3906	Shale
630-1270	Shale and shells	3906-3920	Chert and lime
1270-1550	Shale, salt & shells	3920-4013	Lime and chert
1550-1790	Lime and shale	4013-4025	Shale
1790-1990	Lime with shale streaks	4025-4038	Sand and shale
1990-2100	Lime	4038-4071	Shale
2100-2980	Lime and shale	4071-4109	Lime (Arb.)
2980-3030	Lime	4109	RTD

Set 210' of 8 5/8" surface pipe, cemented with 200 sacks common cement and 5 sacks calcium chloride.

Tops: Heebner - 3287'  
Lansing-KC-3472'  
Viola- 3904'  
Simpson- 4013'  
Arbuckle- 4068'

Drill Stem Tests: No. 1 3668' - 3693' open 1 hr. shut in 30 min.  
Recovered 45' muddy salt water BHP 1350#.

Ran Schlumberger Log

Dry, plugged and abandoned.

State of Kansas )  
County of Barton ) SS.

I, Allan Harms, of the Harms-Burt Drilling Company, being first duly sworn say that I have knowledge of the facts, matters, and statements herein contained and that same are true and correct.

Signed Allan Harms

Subscribed and sworn to before me this 23 day of December, 1954

Mary E Van Pelt  
Notary Public

My Commission expires: 1-20-58

12-24-54

PLUGGING  
WELL SEC 19-24-R 11W  
BOOK PAGE 13 LINE 44

RECORDED  
STATE COMMISSION  
DEC 24 1954  
COUNTY OF STAFFORD