


Give All Information Completely
Make Required Affidavit
Mail or Deliver Report to:
Conservation Division
State Corporation Commission
800 Bitting Building
Wichita, Kansas

OR
FORMATION PLUGGING RECORD

Strike out upper line
when reporting plug-
ging off formations.

NORTH

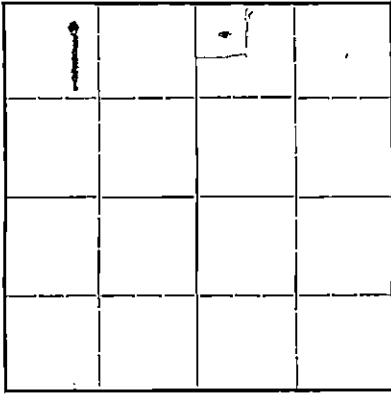

Locate well correctly on above
Section Plot

Stafford County. Sec 18 Twp 24 Rge. (E) 11 (W)
Location as "NE $\frac{1}{4}$ NW $\frac{1}{4}$ SW $\frac{1}{4}$ " or footage from lines. NW $\frac{1}{4}$ - NW $\frac{1}{4}$ - NE $\frac{1}{4}$
Lease Owner Tyson Dines
Lease Name M. Blackburn Well No. 1
Office Address 1210 1st Natl Bank Bldg, Denver, Colo.
Character of Well (completed as Oil, Gas or Dry Hole) Dry hole
Date well completed 10-8-41 19.
Application for plugging filed 10-2-41 19.
Application for plugging approved 10-8-41 19.
Plugging commenced 10-8-41 19.
Plugging completed 10-11-41 19.
Reason for abandonment of well or producing formation Dry hole.

If a producing well is abandoned, date of last production.....19.
Was permission obtained from the Conservation Division or its agents before plugging was com-
menced? Yes

Name of Conservation Agent who supervised plugging of this well CT. Alexander
Producing formation Viola Depth to top 3838' Bottom 3955 Total Depth of Well 3959 Feet
Show depth and thickness of all water, oil and gas formations.

OIL, GAS OR WATER RECORDS


CASING RECORD

Formation	Content	From	To	Size	Put In	Pulled Out
Viola	Water	3839	3840'	5 $\frac{1}{2}$ "	3838'	3140'
Viola	Water	3899'	3901'			

Describe in detail the manner in which the well was plugged, indicating where the mud fluid was placed and the method or methods used in introducing it into the hole. If cement or other plugs were used, state the character of same and depth placed, from.....feet to.....feet for each plug set.

The hole was filled with mud from 3959' to 3901' and bridged and cemented to 3881' and mud to 3839' and bridged and cemented to 3819' and filled with mud to 220' and a permanent bridge of rock and cement placed at 220' up to 200' - Mud up to 30' - cement to top of casing and cellar filled with dirt.

10-17-41

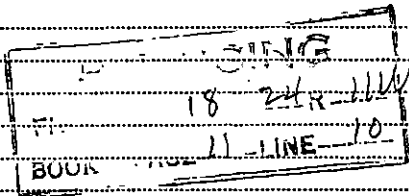

(If additional description is necessary, use BACK of this sheet)

Correspondence regarding this well should be addressed to W.E. Barnes 217 N. Main. Stafford, Kansas
Address.....

STATE OF Kansas, COUNTY OF Stafford, ss.
W.E. Barnes (employee of owner) or (owner or operator) of the above-described well,
being first duly sworn on oath, says: That I have knowledge of the facts, statements, and matters herein contained and the log of the above-described well as filed and that the same are true and correct. So help me God.

(Signature) W.E. Barnes

Stafford, Kansas
(Address)

SUBSCRIBED AND SWORN to before me this 15 day of October, 1941

My commission expires August 4, 1942
Notary Public.

15-185-01080-0000


WELL LOG BUREAU - KANSAS GEOLOGICAL SOCIETY
412 Union National Bldg., Wichita, Kansas

PORTER - DINES ET AL
Blackburn No. 1.

SEC. 18 T. 24 R. 11W
NWc NE

Total Depth. 3958'
Comm. 9-19-41 Comp. 10-3-41
Shot or Treated.
Contractor.
Issued. 10-25-41

County. Stafford

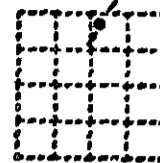

CASING:
8 5/8" 220' Cem.
5 1/2" 3839' Cem.

Elevation.

Production. Dry

Figures Indicate Bottom of Formations.

sand & shale	320
shale	595
anhydrite	620
shale & lime shells	1405
lime brkn	1465
lime	1730
lime brkn	2060
shale & shells	2340
shale	2455
shale & lime shells	2560
shale	2970
lime	3300
shale	3400
lime	3760
shale	3838
lime SO, rotary TD	3840 $\frac{1}{2}$
Cable Tools:	
lime	3857
shale green	3859
chert wh SSO	3861
ran squeeze job 3861	
75 sacks cement	
drilled cement. No show	
chert?, 1 $\frac{1}{2}$ " BW scum	
oil	3864
lime -2500'wtr	3955
shale green	3958
Total Depth.	

Tops: (Samples)

Topoka	2950
Lansing	3420
Kinderhook	3753
Viola	3838
Simpson	3955

LOGGING
 SEC. 18 T. 24 R. 11W
 BOOK PAGE 11 LINE 10.