


STATE OF KANSAS
STATE CORPORATION COMMISSION

WELL PLUGGING RECORD

Give All Information Completely
Make Required Affidavit
Mail or Deliver Report to:
Conservation Division
State Corporation Commission
800 Bitting Building
Wichita, Kansas

NORTH

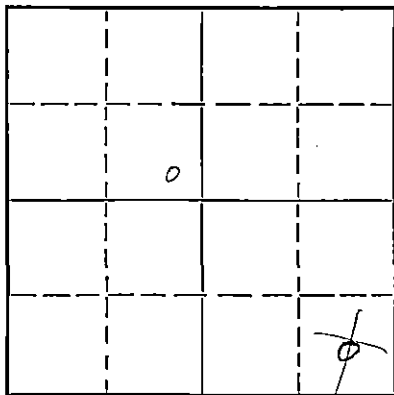

Locate well correctly on above
Section Plat

Stafford County. Sec. 16 Twp. 24S Rge. 11 (E) (W)
Location as "NE/CNW $\frac{1}{4}$ SW $\frac{1}{4}$ " or footage from lines 330 S.L. 330 E.L. NW
Lease Owner S. A. Berwick
Lease Name Peipmaier Well No. 1
Office Address Box 64, Great Bend, Kansas
Character of Well (completed as Oil, Gas or Dry Hole) Dry
Date well completed 9-2-52 19
Application for plugging filed 9-2-52 19
Application for plugging approved 9-2-52 19
Plugging commenced 9-2-52 19
Plugging completed 9-2-52 19
Reason for abandonment of well or producing formation Dry
If a producing well is abandoned, date of last production None 19
Was permission obtained from the Conservation Division or its agents before plugging was commenced? Yes

Name of Conservation Agent who supervised plugging of this well Mr. Rieves
Producing formation - Depth to top - Bottom - Total Depth of Well 4050 Feet
Show depth and thickness of all water, oil and gas formations.

OIL, GAS OR WATER RECORDS

CASING RECORD

Formation	Content	From	To	Size	Put In	Pulled Out

Describe in detail the manner in which the well was plugged, indicating where the mud fluid was placed and the method or methods used in introducing it into the hole. If cement or other plugs were used, state the character of same and depth placed, from 230 feet to 35 feet for each plug set.

Bridged hole 230 ft., cemented with 20 sacks. Bridged hole 35 ft. cemented to top with 15 sacks.

(If additional description is necessary, use BACK of this sheet)

Correspondence regarding this well should be addressed to S. A. Berwick
Address Box 64, Great Bend, Kansas

STATE OF Kansas, COUNTY OF Barton, ss.
S. A. Berwick (employee of owner) or (owner or operator) of the above-described well,
being first duly sworn on oath, says: That I have knowledge of the facts, statements, and matters herein contained and the log of the above-described well as filed and that the same are true and correct. So help me God.

(Signature) S. A. Berwick
Box 64 Great Bend, Kansas (Address)

SUBSCRIBED AND SWORN to before me this 2nd day of September 1952

Clayton Bell Notary Public.

My commission expires 2-16-55

RECEIVED
STATE CORPORATION COMMISSION

SEP 6 - 1952 9-6-52

PLUGGING
FILE REC-1624 R-14
BOOK PAGE 7 LINE 7
CONSERVATION DIVISION
Wichita, Kansas

S. A. BERWICK DRILLING CO.
 P. O. Box 64
 Great Bend, Kansas

Peipmeier #1 SW-SW-NW - 16 24S 11W Stafford County, Kansas

Commenced: 8-19-52
 Completed: 9-2-52
 Total Depth: 4050'

Elevation: 1831' R. B.
 Contractor: S. A. Berwick Drlg. Co.

Strata	Depth
Surface Clay and Sand	0 - 160
Shale and Shells	160 - 231
Red Bed Shale and Shells	231 - 1700
Lime and Shale	1700 - 1845
Sandy Lime	1845 - 1960
Lime and Shale	1960 - 2160
Sandy Lime and Shale	2160 - 2340
Lime and Shale	2340 - 3055
Lime	3055 - 3135
Lime and Shale	3135 - 3490
Lime	3490 - 3789
Lime and Shale	3789 - 3835
Shale and Churt	3835 - 3856
Lime	3856 - 3865
Lime, Shale and Churt	3865 - 3885
Churty Lime and Shale	3885 - 3965
Shale and Sand	3965 - 3990
Shale and Lime	3990 - 4035
Lime	4035 - 4050 T. D.

I hereby certify the above a true and correct log as reflected by the Daily Drilling Reports of the S. A. Berwick Drilling Co.

By S. A. Berwick
 S. A. Berwick, Owner

Signed and sworn in my presence this 5th day of Sept, 1952,
 by S. A. Berwick, Owner of the S. A. Berwick Drilling Co.

Clayton Bell
 Notary Public

My Commission Expires: 2-16-55

PLUGGING
 PRT sec 16 24 11W
 BOOK PAGE 24 LINE 7

STATE CORPORATION COMMISSION
 SEP 6 - 1952
 CONSERVATION DIVISION
 Wichita, Kansas

9-6-52