


STATE OF KANSAS
STATE CORPORATION COMMISSION

WELL PLUGGING RECORD

Give All Information Completely
Make Required Affidavit
Mail or Deliver Report to
Conservation Division
State Corporation Comm.
245 North Water
Wichita, KS 67202

Pratt County. Sec. 21 Twp. 26S Rge. 13W E/W
Location as "NE/CNW $\frac{1}{4}$ /SW $\frac{1}{4}$ " or footage from lines _____
C N/2 SW
Lease Owner Rine Drilling Company
Lease Name Frisbie Well No. 1
Office Address 300 W. Douglas, Suite 600, Wichita, KS
Character of Well (Completed as Oil, Gas or Dry Hole) 67202
Dry Hole

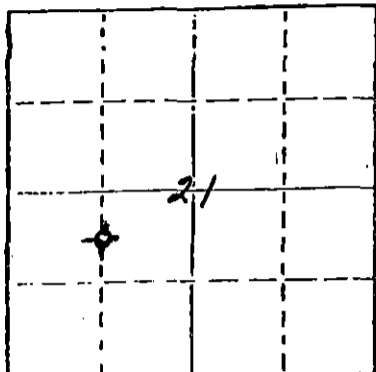

Locate well correctly on above
Section Plat

Date Well completed August 31, 1980
Application for plugging filed August 31, 1980
Application for plugging approved August 31, 1980
Plugging commenced August 31, 1980
Plugging completed August 31, 1980
Reason for abandonment of well or producing formation _____
Dry Hole

If a producing well is abandoned, date of last production _____ 19____

Was permission obtained from the Conservation Division or its agents before plugging was commenced? Yes

Name of Conservation Agent who supervised plugging of this well Wm. T. Owen
Producing formation _____ Depth to top _____ Bottom _____ Total Depth of Well 4463'
Show depth and thickness of all water, oil and gas formations.

OIL, GAS OR WATER RECORDS

CASING RECORD

FORMATION	CONTENT	FROM	TO	SIZE	PUT IN	PULLED OUT
		0'	369'	8-5/8"	362.63'	None

Describe in detail the manner in which the well was plugged, indicating where the mud fluid was placed and the method or methods used in introducing it into the hold. If cement or other plugs were used, state the character of same and depth placed, from _____ feet to _____ feet for each plug set.

Plugged with 40 sacks cement at 600';
40 sacks cement at 360'; 10 sacks cement
at 40'; and 5 sacks cement in rat hole.

RECEIVED
STATE CORPORATION COMMISSION
SEP 22 1980
CONSERVATION DIVISION
Wichita, Kansas

(If additional description is necessary, use BACK of this report)
Name of Plugging Contractor Halliburton Cementing Co.


STATE OF KANSAS COUNTY OF SEDGWICK, ss.
John H. Knightley Agent (employee of owner) or (owner or operator)
of the above-described well, being first duly sworn on oath, says: That I have knowledge of the facts, statements, and matters herein contained and the log of the above-described well as filed and that the same are true and correct. So help me God.

(Signature) John H. Knightley
221 S. Broadway, Wichita, Kansas 67202
(Address)

AND SWORN TO before me this 19th day of September, 19 80

My commission expires March 12, 1983

Stella J. Zipp
Notary Public.

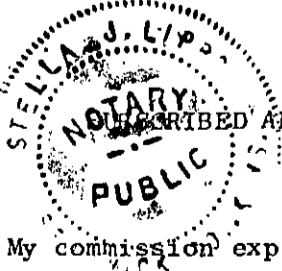

Rine Drilling Company
300 W. Douglas, Suite 600
Wichita, Kansas 67202

- Frisbie #1
C N/2 SW Sec. 21-26S-13W
Pratt County, Kansas

Contractor: D. R. Lauck Oil Company, Inc.
221 S. Broadway, Suite 400
Wichita, Kansas 67202

Commenced: August 23, 1980
Completed: August 31, 1980

Drillers Log

Sand	180
Red Bed	1255
Shale	2095
Shale & Shells	2814
Shale	3205
Shale & Shells	3450
Shale & Lime	3885
Lime & Shale	4285
Lime	4463 RTD

RECEIVED
STATE CORPORATION COMMISSION
SEP 22 1980
CONSERVATION DIVISION
Wichita, Kansas