


WELL PLUGGING RECORD

Give All Information Completely
Make Required Affidavit
Mail or Deliver Report to:
Conservation Division
State Corporation Commission
800 Bitting Building
Wichita, Kansas

Pratt County, Sec. 21 Twp. 26S Rge. 13 (E) 13 (W)

Location as "NE/CNW $\frac{1}{4}$ /SW $\frac{1}{4}$ " or footage from lines SW SW SE
Lease Owner Iron Drilling Company
Lease Name Frisbie Well No. 1
Office Address 1206 Philtower Building Tulsa, Oklahoma
Character of Well (completed as Oil, Gas or Dry Hole) Dry Hole
Date well completed October 28 19 51
Application for plugging filed October 28 19 51
Application for plugging approved October 28 19 51
Plugging commenced October 28 19 51
Plugging completed October 28 19 51
Reason for abandonment of well or producing formation Dry Hole

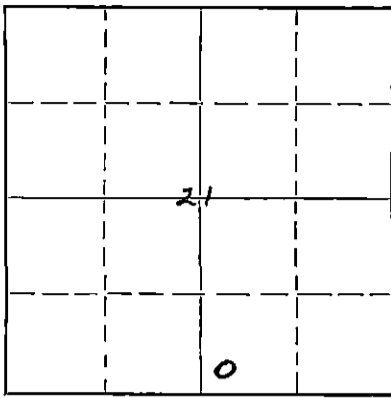

Locate well correctly on above Section Plat

If a producing well is abandoned, date of last production 19...
Was permission obtained from the Conservation Division or its agents before plugging was commenced? Yes

Name of Conservation Agent who supervised plugging of this well C. D. Stough
Producing formation Depth to top Bottom Total Depth of Well 4551 Feet
Show depth and thickness of all water, oil and gas formations.

OIL, GAS OR WATER RECORDS

CASING RECORD

Formation	Content	From	To	Size	Put In	Pulled Out
Sand	Water	825'	859'	8-5/8"	875'	None
Miss.	Water & Show Oil	4263'	4311'	5 1/2"	4372'	3685'

Describe in detail the manner in which the well was plugged, indicating where the mud fluid was placed and the method or methods used in introducing it into the hole. If cement or other plugs were used, state the character of same and depth placed, from feet to feet for each plug set.

4266 to 4246 ft. Sand Bridge
4246 to 4220 5 sax cement
4220 to 250 Mudded
250 to 235 Rock Bridge
235 to 195 15 sax cement
195 to 30 Mud
30 to cellar 10 sax cement

Stamp: NOV - 8 1951
Stamp: REC'D 11-8-51

(If additional description is necessary, use BACK of this sheet)

Correspondence regarding this well should be addressed to Iron Drilling Company
Address 1206 Philtower Building Tulsa, Oklahoma

STATE OF Oklahoma, COUNTY OF Tulsa, ss.
Herrick Babcock (employee of owner) or (owner or operator) of the above-described well,
being first duly sworn on oath, says: That I have knowledge of the facts, statements, and matters herein contained and the log of the above-described well as filed and that the same are true and correct. So help me God.

(Signature) Herrick Babcock
1206 Philtower Building Tulsa, Oklahoma (Address)

SUBSCRIBED AND SWORN to before me this 7th day of November, 19 51

My commission expires Feb. 28, 1952

B. Michal Notary Public.

PLUGGING
FILE SEC 21 X6 R130
BOOK PAGE 141154

DRILLING RECORD

Well No. 1 Frisbie
 Located SW SW SE Sec. 21-26S-13W
 Pratt County, Kansas

Casing Record

875' of 8-5/8" OD Surface
 pipe cemented with 450 sacks.

Work Commenced 8/26/51
 Drilling Commenced 8/27/51
 Drilling Completed 9/16/51
 Work Completed 9/17/51

4372' of 5 1/2" OD Casing
 cemented with 100 sacks.

Pulled 3685'.

WELL LOG

Sand & Clay	0 to 200
Sand & Red Bed	200 to 320
Shale	320 to 430
Sand Shale & Shells	430 to 750
Sand	750 to 765
Shale & Shells	765 to 1810
Shale & Lime	1810 to 2130
Lime	2130 to 2265
Lime & Shale	2265 to 3485
Lime	3485 to 3645
Shale & Lime	3645 to 3920
Lime	3920 to 3985
Lime & Shale	3985 to 4030
Lime	4030 to 4180
Shale & Chert	4180 to 4205
Lime & Cherty Shale	4205 to 4233
Shale & Lime	4233 to 4263
Shale Chert & Lime	4263 to 4300
Chert	4300 to 4315
Shale & Chert	4315 to 4350
Shale	4350 to 4380
Chert	4380 to 4405
Chert Lime	4405 to 4430
Shale & Chert	4430 to 4450
Shale & Lime	4450 to 4531
Top of Arbuckle	4531 to 4550
Arbuckle	4550 to 4551

Miss. Lime 4263 - 4311
 Perforated 4280 - 4288 - Water
 " 4262 - 4270 - 500 gal
 acid. Swab 5 gal Oil & 25
 gal Water per Hour.

Plugged and abandoned 10-28-51

Arbuckle 4531 - 4551 TD - No Shows

Plugged back & set 5 1/2" at 4372.

TD RECORD
 STATE COMMISSION

CERTIFICATION NOV - 8 1951
 CONSERVATION DIVISION
 Wichita, Kansas

State of Oklahoma, County of Tulsa, SS

I, Herrick Babcock, Partner of Iron Drilling Company, Certify that the
 above is a true and correct log of the above described well.

Signature Herrick Babcock

Subscribed to and Sworn before me this 7th day of November, 1951.

PLUGGING

FILE SEC-21-26S-13W

BOOK PAGE 121 LINE 4

My commission expires Feb. 28, 1952.

D. Michal
 Notary Public