


STATE OF KANSAS  
STATE CORPORATION COMMISSION  
200 Colorado Derby Bldg.  
Wichita, Kansas 67202

Form CP-4  
Rev. 12-15-80

WELL PLUGGING RECORD

Give All Information Completely  
Make Required Affidavit

COUNTY Pratt SEC. 23 TWP. 26S RGE. 13W E/W  
Location as in quarters or footage from lines:  
SE SE NE

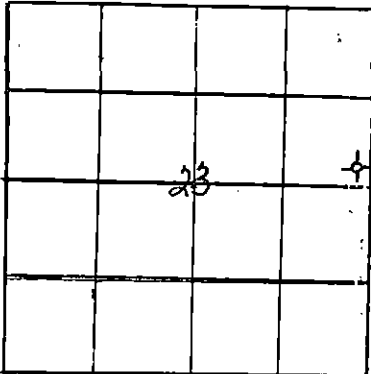

Locate Well  
correctly on above  
Section Platt.

Lease Owner Associated Petroleum Consultants, Inc.  
Lease Name Gobin Well No. #1  
Office Address Suite 600 - One Main Place, Wichita, KS 67202-1399  
Character of Well (Completed as Oil, Gas or Dry Hole): Dry Hole  
Date Well Completed March 28, 1983  
Application for plugging filed March 28, 1983  
Plugging commenced 2:00 a.m.  
Plugging completed 3:00 a.m.  
Reason for abandonment of well or producing formation D & A (c)(L)

Was permission obtained from the Conservation Division or it's  
Agent's before plugging was commenced? yes

Name of Conservation Agent who supervised plugging of this well Bud Metz

Producing formation X Depth to top X bottom X T.D. 4500'

Show depth and thickness of all water, oil and gas formations.

OIL, GAS OR WATER RECORDS

Casing Record

Formation	Content	From	To	Size	Put in	Pulled Out
				8 5/8"	816'	none

Describe in detail the manner in which the well was plugged, indicating where the mud  
fluid was placed and the method or methods used in introducing it into the hold. If cement  
or other plugs were used, state the character of same and depth placed, from        feet  
to        feet for each plug set.

- Ran 50 sacks @ 850'
- 40 sacks @ 400'
- 10 sacks Bridge 40'
- 10 sacks Rat Hole
- 10 sacks Mouse Hole
- 5 sacks Water Well

(If additional description is necessary, use BACK of this sheet)

Name of Plugging Contractor Heartland Drilling, Inc.


STATE OF KANSAS COUNTY OF SEDGWICK, ss.  
PHYLLIS BUCHANAN (employee of owner) ~~owner or operator~~ of the  
above-described well, being first duly sworn on oath, says: That I have knowledge of the  
facts, statements, and matters herein contained and the log of the above-described well as  
filed and that the same are true and correct. So help me God.

(Signature) Phyllis Buchanan  
PHYLLIS BUCHANAN  
(Address)

SUBSCRIBED AND SWORN TO before me this 4th day of April, 19 83

Sherry Wayman  
Notary Public.

My Commission expires:

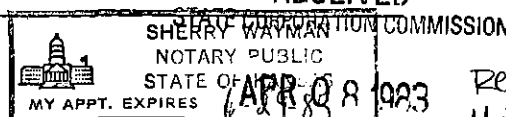

SHERRY WAYMAN