


STATE OF KANSAS  
STATE CORPORATION COMMISSION

WELL PLUGGING RECORD

Give All Information Completely  
Make Required Affidavit  
Mail or Deliver Report to:  
Conservation Division  
State Corporation Commission  
211 No. Broadway  
Wichita, Kansas

Pratt County, Sec. 14 Twp. 26S Rge. 13 (W)  
Location as "NE/CNW/SW" or footage from lines NE NE SW  
Lease Owner Brunson-Spines, Inc.  
Lease Name Tremain #1 Well No. 1  
Office Address 302 Union Center, Wichita, Kansas  
Character of Well (completed as Oil, Gas or Dry Hole) Dry Hole  
Date well completed 2-2-19 59  
Application for plugging filed 2-2-59 59  
Application for plugging approved 2-2-19 59  
Plugging commenced 2-2-19 59  
Plugging completed 2-2-19 59  
Reason for abandonment of well or producing formation Dry Hole

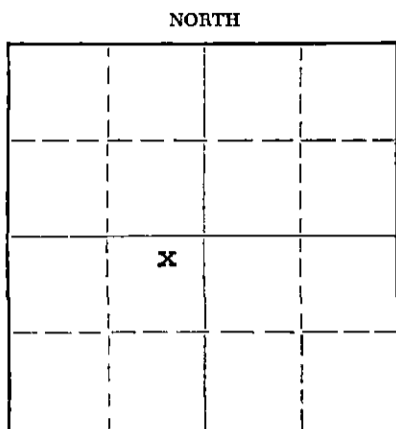

Locate well correctly on above  
Section Plat

If a producing well is abandoned, date of last production 19  
Was permission obtained from the Conservation Division or its agents before plugging was commenced? Yes

Name of Conservation Agent who supervised plugging of this well Frank Broadfoot  
Producing formation Depth to top Bottom Total Depth of Well 4360 Feet  
Show depth and thickness of all water, oil and gas formations.

OIL, GAS OR WATER RECORDS

CASING RECORD

FORMATION	CONTENT	FROM	TO	SIZE	PUT IN	PULLED OUT
				12 1/4"	260'	None
				8-5/8"	792'	None

Describe in detail the manner in which the well was plugged, indicating where the mud fluid was placed and the method or methods used in introducing it into the hole. If cement or other plugs were used, state the character of same and depth placed, from feet to feet for each plug set.

Pushed plug to 240'. Covered with 15 sx. cement and 1/2 sk. hulls, mixed and poured through drill pipe. Pushed plug to 35', covered with 10 sx. cement and 1/2 sk. hulls.

RECEIVED  
STATE CORPORATION COMMISSION  
APR 24 1959  
4-24-59  
CONSERVATION DIVISION  
Wichita, Kansas

(If additional description is necessary, use BACK of this sheet)  
Name of Plugging Contractor Brunson-Spines, Inc.,  
Address 302 Union Center, Wichita, Kansas

STATE OF KANSAS, COUNTY OF SEDGWICK, ss.  
Ralph B. McLaughlin (employee of owner) of the above-described well, being first duly sworn on oath, says: That I have knowledge of the facts, statements, and matters herein contained and the log of the above-described well as filed and that the same are true and correct. So help me God.

(Signature) Ralph B. McLaughlin  
Ralph B. McLaughlin, Secy-Treas.  
302 Union Center, Wichita, Ks.  
(Address)

SUBSCRIBED AND SWORN to before me this 17th day of April, 19 59

Mary G. LaFollette  
Mary G. LaFollette, Notary Public.

My commission expires June 16, 1959

PLUGGING  
FILE SEC 14 T 26 R 13 W  
BOOK PAGE 17 LINE 9

BRUNSON-SPINES, INC.

Wichita, Kansas

WELL: TREMAIN #1

NE NE SW

COMMENCED RD: 1-22-59

14-26S-13W

COMPLETED RD: 2- 2-59

PRATT COUNTY, KANSAS

TOTAL DEPTH: 4360'

ELEVATION: 1920 KB

CASING: 260' - 12 $\frac{1}{4}$ "  
792" - 8-5/8"

CONTRACTOR: BRUNSON-SPINES, INC.

STRATA	DEPTH	TOPS
Sand & Clay	130	Heebner Shale 3558 (-1638)
Sandy Shale	190	Toronto 3580 (-1660)
Red Bed & Shale	345	Douglas Shale 3610 (-1690)
Red Bed w/ Sand	787	Brown Lime 3728 (-1808)
Anhydrite	802	Lansing-Kansas City 3746 (-1826)
Red Bed & Shale w/ Shells	1110	Base Kansas City 4065 (-2145)
Shale	1795	Mississippi 4187 (-2267)
Shale w/ stks. Lime	1845	Simpson Shale 4319 (-2399)
Lime	1985	Simpson Sand 4333 (-2412)
Lime w/ Shale stks.	2075	Total Depth 4360 (-2440)
Lime	2235	
Lime & Shale	2760	
Shale w/ Lime stks.	2925	
Sandy Lime	2955	
Lime & Shale	3385	
Sandy Lime & Shale	3540	
Lime & Shale	3709	
Lime	3849	
Lime w/ stks. Chert	3920	
Lime	4168	
Lime w/ Chert	4222	
Lime, Shale & Chert	4258	
Lime w/ chert	4307	
Lime	4345	
Shale, Sand & Lime	4360	

D & A

RECEIVED  
STATE CONSERVATION COMMISSION  
APR 24 1959  
CONSERVATION DIVISION  
Wichita, Kansas

I hereby certify that the above is a true and correct log of said well as reflected by the daily drilling report.

BRUNSON-SPINES, INC.

*Ralph B. McLaughlin*  
Ralph B. McLaughlin, Secy-Treas.

Signed and sworn to in my presence this 17th day of April, 1959, by Ralph B. McLaughlin, Secretary-Treasurer of Brunson-Spines, Inc., a corporation of the State of Kansas.

*Mary G. LaFollette*  
Mary G. LaFollette, Notary Public

My commission expires June 16, 1959.

PLUGGING  
FILE SEC. 14 T. 26 R. 13W  
BOOK PAGE 17 LINE 9