


STATE OF KANSAS
STATE CORPORATION COMMISSION

Form CP-4

Give All Information Completely
Make Required Affidavit
Mail or Deliver Report to:
Conservation Division
State Corporation Commission
212 No. Market
Wichita, Kansas 67202

WELL PLUGGING RECORD

NORTH

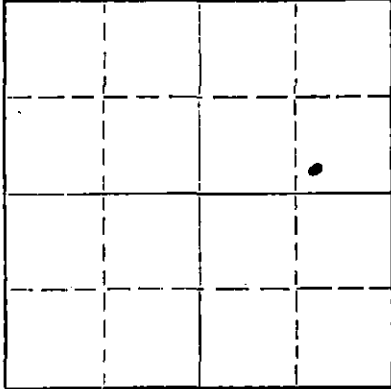

Locate well correctly on above
Section Plat

Pratt County, Sec. 34, Twp. 29S, Rge. (E) 14 (W)
Location as "NE/CNW/SW" or footage from lines SW SE NW
Lease Owner APPLETON OIL COMPANY
Lease Name PAUL Well No. 1
Office Address 2511 Liberty Bank Bldg., Okla. City, Okla. 73102
Character of Well (completed as Oil, Gas or Dry Hole) Dry Hole
Date well completed March 27 April 19 71
Application for plugging filed March 27 19 71
Application for plugging approved March 29 19 71
Plugging commenced March 27 19 71
Plugging completed March 27 19 71
Reason for abandonment of well or producing formation Dry Hole

If a producing well is abandoned, date of last production 19
Was permission obtained from the Conservation Division or its agents before plugging was commenced? Yes

Name of Conservation Agent who supervised plugging of this well G. Russell Biberstien
Producing formation Depth to top Bottom Total Depth of Well 4543' Feet
Show depth and thickness of all water, oil and gas formations.

OIL, GAS OR WATER RECORDS

CASING RECORD

FORMATION	CONTENT	FROM	TO	SIZE	PUT IN	PULLED OUT
				8-5/8"	764'	None

Describe in detail the manner in which the well was plugged, indicating where the mud fluid was placed and the method or methods used in introducing it into the hole. If cement or other plugs were used, state the character of same and depth placed, from feet to feet for each plug set.

Cemented at 720' w/60 sax cement, thru drill pipe with pump truck. Filled with heavy mud and cemented to 40', with 15 sax. Plug set at 720' and 40' from surface.

RECEIVED
STATE CORPORATION COMMISSION
MAY 7 1971
CONSERVATION DIVISION
Wichita, Kansas
5-7-71

(If additional description is necessary, use BACK of this sheet)

Name of Plugging Contractor Gabbert-Jones, Inc.
Address Wichita, Kansas

STATE OF Oklahoma, COUNTY OF Oklahoma, ss.
J.R. Fryer, Production Supt (employee of owner) or (owner or operator) of the above-described well, being first duly sworn on oath, says: That I have knowledge of the facts, statements, and matters herein contained and the log of the above-described well as filed and that the same are true and correct. So help me God.

(Signature) J.R. Fryer
2511 Liberty Bank Bldg., Okla. City, Okla. 73102
(Address)

SUBSCRIBED AND SWORN TO before me this 6th day of May 1971

My commission expires November 25, 1973

Notary Public.

GABBERT-JONES, INC.
WICHITA, KANSAS
DRILLERS' WELL LOG

RECEIVED
 STATE CORPORATION COMMISSION
 MAY 7 1971
 CONSERVATION DIVISION
 Wichita, Kansas

PAUL #1
 SW SE SW, Sec. 34-29S-14W
 Pratt County, Kansas

Commenced: April 17, 1971
 Completed: April 27, 1971

OPERATOR: Appleton Oil Company

DEPTH		FORMATION	REMARKS
From	To		
0	30	Surface Clay	
30	150	Sand	Ran 25 joints of new 20# 8 5/8"
150	780	Redbed and Shells	Casing set @ 763' w/450 saks Halco
780	800	Anhydrite	lite 1/4 # Gilsonite, 200 Sks
800	1360	Shale and Shells	Common 3% HA5, PD @ 10:30 AM
1360	1920	Shale	4/18/71
1920	2725	Lime and Shale	Cement Circ. - Job by Howco
2725	2735	Lime-Shale-Salt	
2735	3310	Lime and Shale	
3310	4530	Lime	
4530	4543	Sand	
4543	TD	D & A	

I, James S. Sutton, II, certify this is a correct copy of the Drillers' Log for the well drilled in the SW SE SW, Section 34-29S-14W, Pratt County, to the best of my knowledge and belief.

James S. Sutton II
 James S. Sutton II

STATE OF KANSAS)
) SS
 COUNTY OF SEDGWICK)

Before me, the undersigned, a Notary Public within and for said County and State, on this 3rd day of May, 1971, personally appeared James S. Sutton II to me personally known to be the identical person who executed the within and foregoing instrument and acknowledged to me that he executed the same as his free and voluntary act and deed for the uses and purposes therein set forth.

IN WITNESS WHEREOF, I have hereunto set my hand and official seal the day and year last above written.



Marjorie Hall
 Marjorie Hall, Notary Public