


STATE OF KANSAS
STATE CORPORATION COMMISSION

WELL PLUGGING RECORD

Give All Information Completely
Make Required Affidavit
Mail or Deliver Report to
Conservation Division
State Corporation Comm.
245 North Water
Wichita, KS 67202

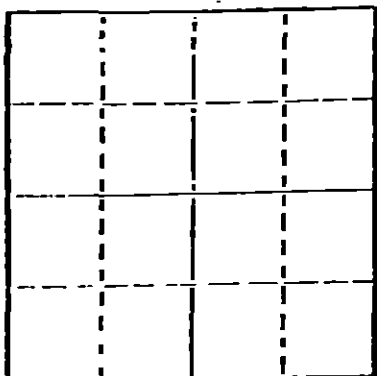

Locate well correctly on above
Section Map

Pratt County. Sec. 34 Twp. 29 Rge. 14 E/W
Location as "NE/CNW $\frac{1}{4}$ SW $\frac{1}{4}$ " or footage from lines
SW SW SW
Lease Owner Midwestern Supply Co.
Lease Name Davis #1 Well No. _____
Office Address Wichita, Kansas
Character of Well (Completed as Oil, Gas or Dry Hole) _____

Date Well completed _____ 19____
Application for plugging filed _____ 19____
Application for plugging approved _____ 19____
Plugging commenced 5/5/76 _____ 19____
Plugging completed 5/8/76 _____ 19____
Reason for abandonment of well or producing formation
depleted.

If a producing well is abandoned, date of last production
_____ 19____

Was permission obtained from the Conservation Division or
its agents before plugging was commenced? yes

Name of Conservation Agent who supervised plugging of this well Biberstein
Producing formation _____ Depth to top _____ Bottom _____ Total Depth of Well 3375
Show depth and thickness of all water, oil and gas formations.

OIL, GAS OR WATER RECORDS

CASING RECORD

FORMATION	CONTENT	FROM	TO	SIZE	PUT IN	PULLED OUT
				8-5/8	954	none
				4 1/2"	2765'	2013'

Describe in detail the manner in which the well was plugged, indicating where the mud fluid was placed and the method or methods used in introducing it into the hold. If cement or other plugs were used, state the character of same and depth placed, from _____ feet to _____ feet for each plug set.

Checked hole, pushed plug to 2500' and ran 20' of sand and 4 sacks cement. ~~Shot~~
Loaded hole, shot pipe at 2203', 2105', 2000', pulled 64 joints. Set 10' rock
bridge at 250' and ran 4 yards ready mix.

PLUGGING COMPLETE.

RECEIVED
STATE CORPORATION COMMISSION
5-13-76
MAY 13 1976

CONSERVATION DIVISION
Wichita, Kansas

(If additional description is necessary, use BACK of this sheet)

Name of Plugging Contractor KELSO CASING PULLING
CHASE, KANSAS

STATE OF KANSAS COUNTY OF RICE
R. DARRELL KELSO (employee of owner) or (owner or operator) of the above-described

well, being first duly sworn on oath, says: That I have knowledge of the facts, statements, and matters herein contained and the log of the above-described well as filed and that the same are true and correct. So help me God.

(Signature) R. Darrell Kelso
CHASE, KANSAS

(Address)

SUBSCRIBED AND SWORN TO before me this 11th day of May, 19 76

My commission expires _____



Margaret Melcher
Notary Public

50-50-

SW¹/₄ 34-29-14

Davis #1

4 1/2" casing @ 2765
140 sack of cement

Surface casing 954 ft of 8 7/8

Cemented 250 3% Sol 2% CC and 250 2% Sol total

475 sacks

total depth 3375

~~Bob Campbell~~
~~686-8761~~

RECEIVED
STATE CORPORATION COMMISSION

APR 19 1976

CONSERVATION DIVISION
Wichita, Kansas