


STATE OF KANSAS  
STATE CORPORATION COMMISSION

WELL PLUGGING RECORD

Give All Information Completely  
Make Required Affidavit  
Mail or Deliver Report to:  
Conservation Division  
State Corporation Commission  
211 No. Broadway  
Wichita, Kansas

Pratt County, Sec. 33 Twp. 26S Rge. 13W (E) (W)  
Location as "NE/CNW/SW" or footage from line NW NW SW  
Lease Owner R. W. Rine Drilling Company  
Lease Name Jo Well No. # 2  
Office Address Star Route, Pratt, Kansas  
Character of Well (completed as Oil, Gas or Dry Hole) EDR  
Date well completed \_\_\_\_\_ 19\_\_\_\_  
Application for plugging filed 12-1-61 19\_\_\_\_  
Application for plugging approved yes 19\_\_\_\_  
Plugging commenced 12-8-61 19\_\_\_\_  
Plugging completed 12-21-61 19\_\_\_\_  
Reason for abandonment of well or producing formation \_\_\_\_\_

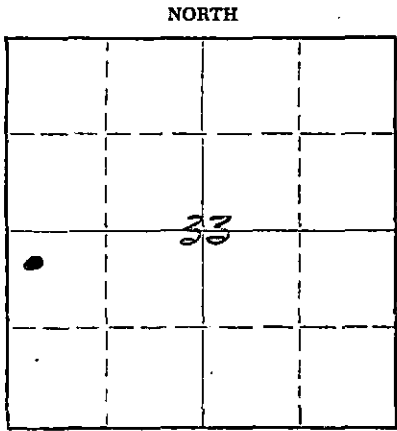

Locate well correctly on above  
Section Plat

If a producing well is abandoned, date of last production \_\_\_\_\_ 19\_\_\_\_  
Was permission obtained from the Conservation Division or its agents before plugging was commenced? yes

Name of Conservation Agent who supervised plugging of this well Fred Hampel  
Producing formation \_\_\_\_\_ Depth to top \_\_\_\_\_ Bottom \_\_\_\_\_ Total Depth of Well PBL 390' Feet  
Show depth and thickness of all water, oil and gas formations.

OIL, GAS OR WATER RECORDS

CASING RECORD

FORMATION	CONTENT	FROM	TO	SIZE	PUT IN	PULLED OUT
				5 1/2"		2,944'

STATE CORPORATION COMMISSION  
JAN 13 1962  
CONSERVATION DIVISION  
Wichita, Kansas  
1-12-62

Describe in detail the manner in which the well was plugged, indicating where the mud fluid was placed and the method or methods used in introducing it into the hole. If cement or other plugs were used, state the character of same and depth placed, from \_\_\_\_\_ feet to \_\_\_\_\_ feet for each plug set.

Plugging commenced 12-8-61. Plugging completed 12-21-61.

Measured in to total depth: plug at 4390'.

Sanded back to 4220' and dumped 5 sacks cement.

Loaded hole with water. Worked and shot 5 1/2" casing free at 2944'.  
Built rack and slide. Pulled and layed down casing.

Bailed down hole. Mudded up to 300' and set 10' rock bridge.  
Dumped 20 sacks cement. Mudded up to 35' and set 10' rock bridge.  
Capped the well with 10 sacks cement.

(If additional description is necessary, use BACK of this sheet)

Name of Plugging Contractor Forbes Casing Pulling, Inc.  
Address P. O. Box 221 Great Bend, Kansas

STATE OF Kansas, COUNTY OF Barton, ss.  
J. O. Forbes (employee of owner) or (owner or operator) of the above-described well, being first duly sworn on oath, says: That I have knowledge of the facts, statements, and matters herein contained and the log of the above-described well as filed and that the same are true and correct. So help me God.

(Signature) J. O. Forbes  
Great Bend, Kansas  
(Address)

SUBSCRIBED AND SWORN TO before me this 3rd day of January, 1962

My commission expires December 8th, 1963

Kayann Jenkins  
Kayann Jenkins Notary Public.

Jo Well No. 2

NW NW SW  
 Sec. 33-26S-13W  
 Pratt County  
 Kansas

Contractors: The E. W. Rine Drilling Company  
 Started 10/27/50 Finished 11/12/50

LOG

Sand	0 - 185	
Sand - Shale	185 - 770	Syfo @ 500' - 0.5.
Shale	770 - 797	2-1/8" csg. @ 795 w/ 400 3x.
Red Red - Shale - Shells	797 - 1750	Syfo @ 1000' - 0
Salt	1350 - 1540	Syfo @ 1500' - 3/4°
Shale	1540 - 2000	Syfo @ 2000' - 3/4°
Lime - Shale	2000 - 2730	Syfo @ 2500' - 0°
Sand	2730 - 2830	
Shale	2830 - 2980	
Lime - Shale	2980 - 3135	Syfo @ 3000' - 1/2°
Lime	3135 - 3280	
Shale	3280 - 3400	
Lime - Shale	3400 - 3550	
Lime	3550 - 3870	Syfo @ 3660' - 0.5.
Lime - Shale	3870 - 3936	
Lime	3936 - 4036	
Lime - Shale	4036 - 4192	
Lime	4192 - 4230	
Lime - Shale	4230 - 4262	
Lime	4262 - 4343	
Sand	4343 - 4346	
Core #1	4346 - 4349	
Chert	4349 - 4350	
Core #2	4350 - 4354	
Sand	4354 - 4365	
Shale - Lime	4365 - 4425	
Lime	4425 - 4434	M.D. 5 1/2" csg. @ 4432 w/ 250 3x.
Tops		
Heebner	3628	
Brown Lansing	3778	
White Lansing	3802	
Conglomerate	4214	
Kinderhook	4222	
Viola	4240	
Simpson	4342	
Arbuckle	4430	

**RECEIVED**  
 STATE CORPORATION COMMISSION

JAN 12 1962

CONSERVATION DIVISION  
 Wichita, Kansas

1-12-62

State of Kansas )  
 County of Sedgwick ) ss

I, E. H. Sloyer, do hereby certify that the above is a true and accurate log of the Jo Well No. 2, located in the NW NW SW of Section 33-26S-13W, Pratt County, Kansas.

*E. H. Sloyer*  
 Secretary

Subscribed to and sworn before me this 16th day of November, 1950

Notary Public

My Commission Expires Dec. 23, 1952