


STATE OF KANSAS
STATE CORPORATION COMMISSION

Give All Information Completely
Make Required Affidavit
Mail or Deliver Report to:
Conservation Division
State Corporation Commission
211 No. Broadway
Wichita, Kansas

15-151-10848-005 *Pale Copy*
WELL PLUGGING RECORD

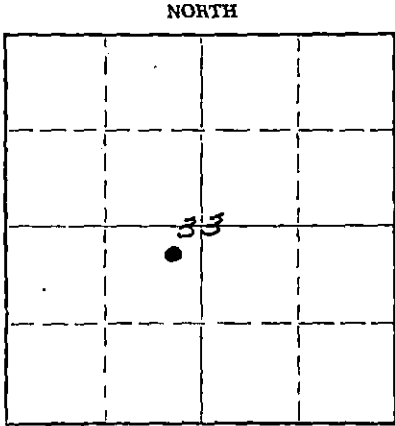

Locate well correctly on above Section Plat

Pratt County. Sec. 33 Twp. 26S Rge. 13W (E) (W)
Location as "NE/CNW/SW" or footage from lines NE NE SW
Lease Owner R. W. Rine Drilling Company
Lease Name Jo Well No. # 1
Office Address Star Route, Pratt, Kansas
Character of Well (completed as Oil, Gas or Dry Hole) _____
Date well completed _____ 19____
Application for plugging filed yes 19____
Application for plugging approved yes 19____
Plugging commenced 11-29-61 19____
Plugging completed 12-3-61 19____
Reason for abandonment of well or producing formation _____

If a producing well is abandoned, date of last production _____ 19____
Was permission obtained from the Conservation Division or its agents before plugging was commenced? yes

Name of Conservation Agent who supervised plugging of this well Hampel
Producing formation _____ Depth to top _____ Bottom _____ Total Depth of Well PB 4140' Feet
Show depth and thickness of all water, oil and gas formations. RTD 4144'

OIL, GAS OR WATER RECORDS

CASING RECORD

FORMATION	CONTENT	FROM	TO	SIZE	PUT IN	PULLED OUT
				5 1/2"		3,054'

Describe in detail the manner in which the well was plugged, indicating where the mud fluid was placed and the method or methods used in introducing it into the hole. If cement or other plugs were used, state the character of same and depth placed, from _____ feet to _____ feet for each plug set.

STATE CORPORATION COMMISSION
JAN 12 1962
CONSERVATION DIVISION
Wichita, Kansas

Plugging commenced 11-29-61. Plugging completed 12-3-61.

Measured in to total depth: plug at 4140'.

Sanded back to 3775' and dumped 5 sacks cement. 1-12-62

Loaded hole with water. Worked & shot 5 1/2" casing free at 3,054'.
Built rack and slide. Pulled and layed down casing.

Bailed hole down. Mudded up to 300' and set 10' rock bridge.
Dumped 20 sacks cement. Mudded up to 35' and set 10' rock bridge.
Capped the well with 10 sacks cement.

(If additional description is necessary, use BACK of this sheet)

Name of Plugging Contractor Forbes Casing Pulling, Inc.
Address P. O. Box 221 Great Bend, Kansas

STATE OF Kansas, COUNTY OF Barton, ss.
J. O. Forbes (employee of owner) or (owner or operator) of the above-described

well, being first duly sworn on oath, says: That I have knowledge of the facts, statements, and matters herein contained and the log of the above-described well as filed and that the same are true and correct. So help me God.

(Signature) J. O. Forbes
Great Bend, Kansas
(Address)

SUBSCRIBED AND SWORN TO before me this 14th day of December, 19 61

My commission expires December 8th, 1963

Kayam Jenkins
Notary Public.

15-151-10848-0000

Joe Well No. 1

NE NE SW
Sec. 33-26-13W
Pratt County, Kansas

RECEIVED
STATE CORPORATION COMMISSION
JAN 12 1962
CONSERVATION DIVISION
Wichita, KS
1-12-62

Contractor: R. W. Rine Drilling Company
Started: 9/18/49 Finished: 10/7/49

	LOG
Surface dirt, sand	0- 300
Gravel, shale	300- 425
Red rock, shells	425- 820 12 3/8" w/ 250 sk. @ 300'
Red bed, Anhydrite	820- 878 8-5/8" w/ 100 sk. @ 878'
Red bed, shale	878-1345
Shale, salt	1345-1580
Shale, shells	1580-1820
Lime, shale	1820-2990
Lime, sand	2990-3030
Sandy lime, shale	3030-3080
Lime	3080-3205
Lime, shale	3205-3320
Shale, lime	3320-3660
Shale	3660-3669
Sand	3669-3710
Sand, shale, lime	3710-3790
Shale, lime	3790-3840
Lime	3840-3945
Shale, lime	3945-4000
Lime	4000-4253
Lime and chert	4253-4328
Shale, lime	4328-4345
Sand	4345-4360
Sand, shale	4360-4395
Shale, lime	4395-4433
Lime	4433-4435 TD 5 1/2" w/ 250 sk. @ 4432 1/2'
Top Kansas City	3792'
Top Conglomerate	4190'
Top Viola	4242'
Top Simpson Shale	4330'
Top Simpson Sand	4352'
Top Arbuckle	4432'
TD	4436'

State of Kansas)
County of Sedgwick) ss

I, E. H. Sloyer, do hereby certify that the above is a true and accurate log of the Joe No. 1 well in the NE NE SW of Sec. 33-26-13, Pratt County, Kansas.

E. H. Sloyer
Secretary

Sworn to and subscribed before me this 12th day of October, 1949.

R. M. Green
Notary Public

My commission expires December 29, 1952.