


Give All Information Completely
Make Required Affidavit
Mail or Deliver Report to:
Conservation Division
State Corporation Commission
211 No. Broadway
Wichita, Kansas

WELL PLUGGING RECORD

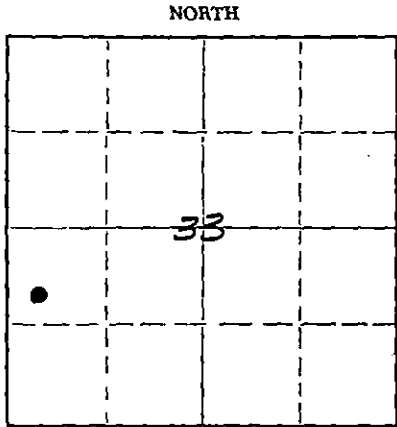

Locate well correctly on above Section Plat

Pratt County, Sec. 33 Twp. 26S Rge. 13W (E) (W)
Location as "NE/CNW/SW" or footage from lines SW NW SW
Lease Owner R. W. Rine Drilling Company
Lease Name Jo Well No. # 5
Office Address Star Route, Pratt, Kansas
Character of Well (completed as Oil, Gas or Dry Hole)
Date well completed 19
Application for plugging filed yes 19
Application for plugging approved yes 19
Plugging commenced 12-1-61 19
Plugging completed 12-7-61 19
Reason for abandonment of well or producing formation

If a producing well is abandoned, date of last production 19
Was permission obtained from the Conservation Division or its agents before plugging was commenced? yes

Name of Conservation Agent who supervised plugging of this well Hampel
Producing formation Depth to top Bottom Total Depth of Well PBL 324' Feet
Show depth and thickness of all water, oil and gas formations. RTD 4480'

OIL, GAS OR WATER RECORDS

CASING RECORD

FORMATION	CONTENT	FROM	TO	SIZE	PUT IN	PULLED OUT
				5 1/2"		3,058'

Describe in detail the manner in which the well was plugged, indicating where the mud fluid was placed and the method or methods used in introducing it into the hole. If cement or other plugs were used, state the character of same and depth placed, from feet to feet for each plug set.

Plugging commenced 12-1-61. Plugging completed 12-7-61.
Measured in to total depth: plug at 1324'.
Sanded back to 1290' and dumped 5 sacks cement.
Loaded hole with water. Worked & shot 5 1/2" casing free at 3,058'.
Built rack and slide. Pulled and layed down casing.
Bailed hole down. Mudded up to 300' & set 10' rock bridge.
Dumped 20 sacks cement. Mudded up to 35' & set 10' rock bridge.
Capped the well with 10 sacks cement.

1-12-62
RECEIVED
STATE CORPORATION COMMISSION
JAN 12 1962
CONSERVATION DIVISION
Wichita, Kansas

(If additional description is necessary, use BACK of this sheet)

Name of Plugging Contractor Forbes Casing Pulling, Inc.
Address Box 221 Great Bend, Kansas

STATE OF Kansas COUNTY OF Barton ss.
J. O. Forbes (employee of owner) or (owner or operator) of the above-described well, being first duly sworn on oath, says: That I have knowledge of the facts, statements, and matters herein contained and the log of the above-described well as filed and that the same are true and correct. So help me God.

(Signature) J. O. Forbes
Great Bend, Kansas
(Address)

SUBSCRIBED AND SWORN TO before me this 11th day of December, 1961

My commission expires December 8th, 1963

Kayann Jenkins
Notary Public.

SW-NW-SW,
SEC. 33-26s-13W
PRATT COUNTY, KANSAS

JO WELL No. 5

CONTRACTOR: THE R. W. RINE DRILLING COMPANY
STARTED: 1-10-53 FINISHED: 1-26-53

LOG

SAND-SHALE SHELLS	0	-	540	
RED BED - SHALE	540	-	830	
ANHYDRITE	830	-	850	8-5/8" csg. @ 847' w/340 sx
PLUG & CEMENT	820	-	850	AND 63 SX STRATOCRETE
SHALE & SHELLS	850	-	1710	SYFO @ 1000' - 0°
SAND & LIME	1710	-	1960	SYFO @ 1500' - 0°
SHALE - LIME & SHELLS	1960	-	2150	SYFO @ 2000' - 0°
LIME & SHALE	2150	-	2340	
LIME	2340	-	2475	
LIME & SHALE	2475	-	2790	SYFO @ 2500' - 1/2°
SHALE	2790	-	2960	
LIME & SHALE	2960	-	3485	SYFO @ 3000'
LIME	3485	-	3660	SYFO @ 3500'
SHALE & LIME	3660	-	3794	
LIME	3794	-	3848	
LIME & SHALE	3848	-	3905	
LIME	3905	-	4010	SYFO @ 4000'
LIME & SHALE	4010	-	4040	
LIME	4040	-	4223	
CHERT & LIME	4223	-	4270	
LIME & SHALE	4270	-	4292	
CHERT & LIME	4292	-	4340	
LIME & SHALE	4340	-	4387	
SHALE, LIME & SAND	4387	-	4430	
LIME & CHERT	4430	-	4458	
LIME	4458	-	4480	

RECEIVED
STATE COMMISSION
JAN 12 1962
CONSERVATION DIVISION
Wichita, Kansas 672
1-12


T.D. RKB

5 1/2" csg. @ 4467' w/200 sx

I, R. M. GREEN, DO HEREBY CERTIFY THAT THE ABOVE IS A TRUE AND ACCURATE LOG OF THE JO WELL No. 5 LOCATED SW-NW-SW, SECTION 33-26s-13w, PRATT COUNTY, KANSAS.


ASSISTANT SECRETARY

SUBSCRIBED TO AND SWORN BEFORE ME THIS 4th DAY OF FEBRUARY, 1953.


NOTARY PUBLIC

MY COMMISSION EXPIRES APRIL 20, 1955.