


WELL PLUGGING RECORD

Give All Information Completely
Make Required Affidavit
Mail or Deliver Report to:
Conservation Division
State Corporation Commission
211 No. Broadway
Wichita, Kansas

Pratt County, Sec. 33 Twp. 26 Rge. (E) 13 (W)

Location as "NE/CNW/SW" or footage from lines NW NW SE
Lease Owner McAdams Pipe & Supply Company
Lease Name Lemon Well No. 1
Office Address 2700 North Main, Great Bend, Kansas
Character of Well (completed as Oil, Gas or Dry Hole) oil
Date well completed 19
Application for plugging filed November 4 1963
Application for plugging approved 19
Plugging commenced November 15 1963
Plugging completed November 21 1963
Reason for abandonment of well or producing formation depleted

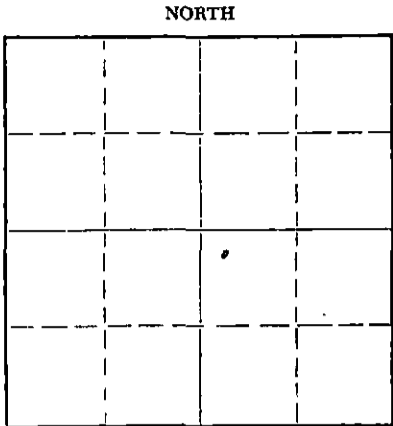

Locate well correctly on above Section Plat

If a producing well is abandoned, date of last production 19
Was permission obtained from the Conservation Division or its agents before plugging was commenced? yes

Name of Conservation Agent who supervised plugging of this well Herman E. Justus
Producing formation Depth to top Bottom Total Depth of Well 4440 Feet
Show depth and thickness of all water, oil and gas formations.

OIL, GAS OR WATER RECORDS

CASING RECORD

FORMATION	CONTENT	FROM	TO	SIZE	PUT IN	PULLED OUT
		0	782'	8 5/8"	782'	none
		0	4440'	5 1/2"	4440'	3146.24

Describe in detail the manner in which the well was plugged, indicating where the mud fluid was placed and the method or methods used in introducing it into the hole. If cement or other plugs were used, state the character of same and depth placed, from feet to feet for each plug set.

Push plug to 3800', set 10' rock bridge and dump 5 sacks of cement.
Bail hole down from 50' to 300', set 10' rock bridge and dump 25 sacks of cement. Fill with mud to 40', set 10' rock bridge and cap with 10 sacks of cement.

RECEIVED
STATE CORPORATION COMMISSION
NOV 27 1963
11-27-63
CONSERVATION DIVISION
Wichita, Kansas

(If additional description is necessary, use BACK of this sheet)
Name of Plugging Contractor Pipe Pullers, Inc.
Address Box 486, Ellinwood, Kansas

STATE OF Kansas, COUNTY OF Barton, ss.
Dean Wells (employee of owner) or (owner-or-operator) of the above-described well, being first duly sworn on oath, says: That I have knowledge of the facts, statements, and matters herein contained and the log of the above-described well as filed and that the same are true and correct. So help me God.

(Signature) Dean Wells
Ellinwood, Kansas (Address)

SUBSCRIBED AND SWORN TO before me this 25th day of November 1963
Sergeant Meyer Notary Public.

My commission expires Feb. 10, 1967

WELL LOG BUREAU -- KANSAS GEOLOGICAL SOCIETY
508 East Murdock, Wichita, Kansas


COPY

Company - R. W. RINE DRILLING COMPANY
Farm - Lemon No. 1

SEC. 33 T. 26 R. 13
NW NW SE

Total Depth. 4442
Comm. 5-23-49 Comp. 6-9-49
Shot or Treated.
Contractor. R. W. Rine Drlg. Co.
Issued. 9-24-49

County. Pratt
KANSAS

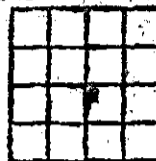

Elevation. _____

Production. 60 bbls oil plus
12 % water

CASING:

8 5/8" 782' cem w/500 sx.
5 1/2" 4440' cem w/250 sx.

Figures Indicate Bottom of Formations.

sand, shale	540
shale	560
sand	595
shale, shells	784
cement	784
shale, shells	1240
shale	1505
shale, shells	1650
lime, shale	1850
lime	1905
shale, lime	1980
lime	2090
lime, shale	2405
shale	2505
lime, shale	2615
shale	2700
lime, shale	2830
shale	3135
shale, shells	3220
lime, shale	3430
lime brkn	3565
lime, shale	3765
lime	4201
sand, shale	4252
lime, shale cherty	4294
chert, sand	4335
Simpson sand, shale	4393
shale	4442
Total depth	

Tops:

Kansas City	3793
Conglomerate	4190
Viola	4246
Simpson shale	4334
Simpson sand	4336
Arbuckle	4435

11-20-63
RECEIVED
STATE CORPORATION COMMISSION
NOV 20 1963
CONSERVATION DIVISION
Wichita, Kansas