


15-151-10836-66-00

STATE OF KANSAS
STATE CORPORATION COMMISSION

Give All Information Completely
Make Required Affidavit
Mail or Deliver Report to:
Conservation Division
State Corporation Commission
800 Bittling Building
Wichita, Kansas

WELL PLUGGING RECORD

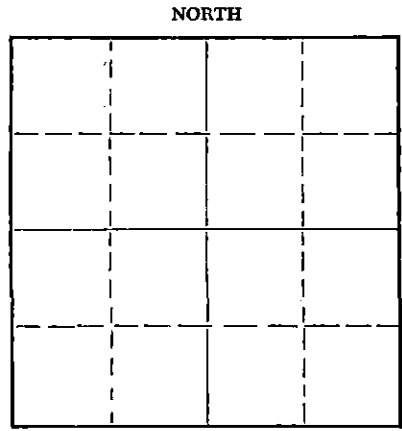

Locate well correctly on above
Section Plat

Bart County. Sec. 33 Twp. 26S Rge. 13W ~~(13E)~~
Location as "NE/CNW/SW" or footage from lines C NE NW NW
Lease Owner Sunray Mid-Continent Oil Company
Lease Name Taylor Well No. 7
Office Address Box 195, Great Bend, Kansas
Character of Well (completed as Oil, Gas or Dry Hole) Dry Hole
Date well completed June 2 1955
Application for plugging filed June 2 1955
Application for plugging approved June 4 1955
Plugging commenced June 2 1955
Plugging completed June 2 1955
Reason for abandonment of well or producing formation Dry Hole

If a producing well is abandoned, date of last production _____ 19____
Was permission obtained from the Conservation Division or its agents before plugging was commenced? yes

Name of Conservation Agent who supervised plugging of this well Warren Horner
Producing formation _____ Depth to top _____ Bottom _____ Total Depth of Well 4490 Feet
Show depth and thickness of all water, oil and gas formations.

OIL, GAS OR WATER RECORDS

CASING RECORD

FORMATION	CONTENT	FROM	TO	SIZE	PUT IN	PULLED OUT
Lansing-Kansas City		376		8 5/8	928	
Mississippi		4173				
Viola		4276				
Arbuckle Lime		4404				

Describe in detail the manner in which the well was plugged, indicating where the mud fluid was placed and the method or methods used in introducing it into the hole. If cement or other plugs were used, state the character of same and depth placed, from _____ feet to _____ feet for each plug set.

Plugged hole with 40 sacks at 300 feet and 10 sacks at 40 feet.

Well log attached.

(If additional description is necessary, use BACK of this sheet)

Name of Plugging Contractor Stickle Drilling Company
Address Tulsa, Oklahoma

STATE OF Kansas, COUNTY OF Barton, ss.
Norman E. Montgomery (employee of owner) or ~~(owner or operator)~~ of the above-described well, being first duly sworn on oath, says: That I have knowledge of the facts, statements, and matters herein contained and the log of the above-described well as filed and that the same are true and correct. So help me God.

(Signature) Norman E. Montgomery
Box 195, Great Bend, Kansas
(Address)

SUBSCRIBED AND SWORN to before me this 22 day of June, 1955

My commission expires 3/27/1957

[Signature] Notary Public.
STATE CORPORATION COMMISSION
JUN 23 1955 6-23-55

RECEIVED
STATE CORPORATION COMMISSION
JUN 23 1955
CONSERVATION DIVISION
Wichita, Kansas
PLUGGING
SEC 33 T 26 R 13W
PAGE 124 LINE 17

Sunray Mid-Continent Oil Company
Tulsa, Oklahoma

Tulsa, Oklahoma
June 8, 1955

CONTRACTOR: Stickle Drilling Company
Drilling Commenced: May 14, 1955
Drilling Completed: June 2, 1955

Taylor #7 N/2 NW Section
33-26S-13W, Pratt County,
Kansas.

DRILLERS LOG

Shale	0-160
Sand	160-225
Shale & Shells	225-280
Red Bed	280-640
Shale & Sand	640-855
Sand & Red Bed	855-929
Shale & Sand	929-995
Anhydrite	995-1025
Shale & Shells	1025-1685
Shale & Lime	1685-1900
Lime	1900-2035
Shale & Lime	2035-2565
Shale	2565-2740
Shale & Lime	2740-3010
Lime & Shale	3010-3445
Lime	3445-3557
Shale & Lime	3557-3748
Lime	3748-3834
Lime & Shale	3834-3882
Lime	3882-3928
Lime & Shale	3928-4145
Lime	4145-4174
Cherty Lime	4174-4248
Lime	4248-4260
Cherty-Lime	4260-4320
Cherty Lime & Shale	4320-4347
Sand & Lime	4347-4371
Lime	4371-4490 TD

I, Frank E. Stickle hereby certify the above to be a true and complete Drillers Log of the Sunray Mid-Continent Oil Company's Taylor #7 N/2 NW Section 33-26S-13W, Pratt County, Kansas:

Frank E. Stickle
Frank E. Stickle

Lillian T. Bonham
Notary Public

February 13, 1956
My Commission Expires

PLUGGING
ALL SEC 33 T26 R 13W
WICK 124 UNIT 17

RECEIVED
STATE CORPORATION COMMISSION
JUN 23 1955
CONSERVATION DIVISION
Wichita, Kansas

6-23-55