


STATE OF KANSAS  
STATE CORPORATION COMMISSION

WELL PLUGGING RECORD

Give All Information Completely  
Make Accurate Affidavit  
Mail or Deliver Report to:  
Conservation Division  
State Corporation Commission  
800 Bittling Building  
Wichita, Kansas

NORTH

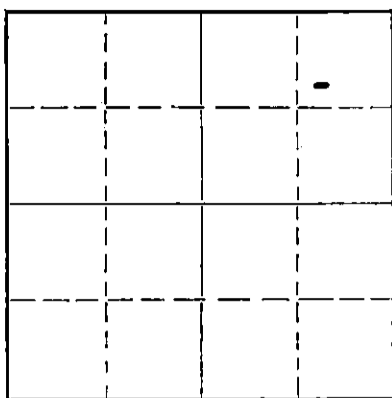

Locate well correctly on above  
Section Plat

Pratt County. Sec. 25 Twp. 26 Rge. 13 (W)  
Location as "NE/CNW $\frac{1}{4}$ SW $\frac{1}{4}$ " or footage from lines SW/NE/NE  $\frac{1}{4}$   
Lease Owner Mid-Continent Petroleum Corporation  
Lease Name L. Knop Well No. 2  
Office Address 512 Orpheum Bldg. Wichita, Kansas  
Character of Well (completed as Oil, Gas or Dry Hole) Oil &  
Date well completed 6-9-1943  
Application for plugging filed September 26 1951  
Application for plugging approved 19  
Plugging commenced October 22, 1951  
Plugging completed November 3, 1951  
Reason for abandonment of well or producing formation 99% water lbbl oil

If a producing well is abandoned, date of last production September 30 1951  
Was permission obtained from the Conservation Division or its agents before plugging was commenced? Yes

Name of Conservation Agent who supervised plugging of this well C. D. Stough  
Producing formation Lansing Depth to top 3873' Bottom 3926' Total Depth of Well 3939' Feet  
Show depth and thickness of all water, oil and gas formations.

OIL, GAS OR WATER RECORDS

CASING RECORD

Formation	Content	From	To	Size	Put In	Pulled Out
Arbuckle Lime	Oil & water	4333 $\frac{1}{2}$ '	4314'	Lane Wells Plug set at	3939'	4275'
Lansing Lime	Oil & water	3926'	3873'	5 $\frac{1}{2}$ " OD	4350'	2991'
				8 5/8 OD	440'	None

Describe in detail the manner in which the well was plugged, indicating where the mud fluid was placed and the method or methods used in introducing it into the hole. If cement or other plugs were used, state the character of same and depth placed, from \_\_\_\_\_ feet to \_\_\_\_\_ feet for each plug set.

Lane wells Plug set at 4275'  
Lane Wells Plug set at 3939'  
Total depth before work over 4333 $\frac{1}{2}$ '  
Hole filled with crushed rock from 3939' to 3860' Run 5 sacks cement with dump bailer.  
Hole filled with mud from 3860' to 150' Set rock bridge at 150' Cemented with 15 sacks cement with dump bailer, mud from 150' to 30' Cemented with 10 sacks cement to bottom of cellar. Cellar to be filled to ground level when derrick is removed.

RECEIVED  
STATE CORPORATION COMMISSION  
NOV 21 1951  
CONSERVATION DIVISION  
WICHITA, KANSAS

11-21-51

(If additional description is necessary, use BACK of this sheet)

Correspondence regarding this well should be addressed to R. L. Mankey  
Address 512 Orpheum Bldg., Wichita, Kansas.

STATE OF Kansas COUNTY OF Barton, ss.  
R. O. Bobey (employee of owner) or (owner) of the above-described well,  
being first duly sworn on oath, says: That I have knowledge of the facts, statements, and matters herein contained and the log of the above-described well as filed and that the same are true and correct. So help me God.

(Signature) R. O. Bobey  
Ellenwood Texas R.P. # 1  
(Address)

SUBSCRIBED AND SWORN to before me this 16 day of November, 1951  
J. M. Fuller Notary Public.

My commission expires 16 June 1952 22-5133-s 9-48-10M

PLUGGING  
FILE SEC. 25 T. 26 R. 13  
BOOK PAGE 118 LINE 17

RXM

COMPANY - Mid-Continent Petroleum Corp.  
 FARM - Louis Knop Well #2

Sec. 25 T. 26S R. 13W  
 SW NE NE

Total Depth - 4333 1/2'  
 Comm. - 5-8-43 Comp. 6-9-43  
 Shot or treated - 1500 gal.  
 Contractor - Parker Drlg. Co.

COUNTY - Pratt  
 Elevation 1926 DF

CASING:  
 8 5/8" 24# S.H.L.W. 440'  
 5 1/2" 17# New S.S. 4316'

Production 1201 bopd

Sandy top soil	0	10
Sand	10	90
Sand & shale	90	292
Sand & gravel	292	300
Red bed	300	440
Sand & red bed	440	805
Anhydrite	805	830
Red bed & shale	830	1090
Shale & shells	1090	1160
Red bed & shale	1160	1390
Shale & shells	1390	1800
Lime & shale	1800	2154
Sandy lime	2154	2280
Lime, cherty	2280	2300
Sandy lime	2300	2342
Shale & shells	2342	2430
Lime & red bed	2430	2540
Lime, shells & sand	2540	2640
Lime & shale	2640	2952
Lime	2952	2970
Lime & shale	2970	3020
Lime	3020	3392
Lime & shale	3392	3455
Lime	3455	3593
Lime & shale	3593	3635
Lime	3635	3650
Lime & shale	3650	3692
Lansing, brown lime	3692	3720
Lansing, white lime	3720	3836
Winterset lime	3836	3929
Lime & shale	3929	3992
Lime	3992	4002
Lime & shale	4002	4060
Lime	4060	4088
Cherty conglomerate	4088	4104
Shale	4104	4116
Viola lime	4116	4158
Cherty shale	4158	4200
Lime & chert	4200	4228
Sand & shale	4228	4253
Sand	4253	4268
Sand & shale	4268	4310
Shale	4310	4314
Silicious lime, Arbuckle	4314	4318
Arbuckle, hard	4318	4323
Arbuckle, soffer w/ gr. sh.	4323	4327
Arbuckle, harder	4327	4329
Arbuckle, slight porosity	4329	4331 1/2
Arbuckle, slight porosity	4331 1/2	4333 1/2
TOTAL DEPTH	4333 1/2	

11-21-51

FILE SEC 25 T. 26S R. 13W  
 BOOK PAGE 11 LINE 17

RECEIVED  
 NOV 21 1951  
 DIVISION  
 Kansas