


STATE OF KANSAS
STATE CORPORATION COMMISSION

Form CP-4

Give All Information Completely
Make Required Affidavit
Mail or Deliver Report to:
Conservation Division
State Corporation Commission
P. O. Box 17027
Wichita, Kansas 67217
NORTH

WELL PLUGGING RECORD

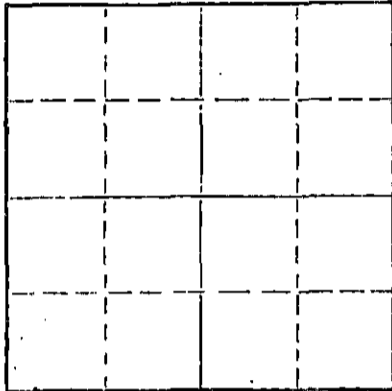

Locate well correctly on above
Section Plat

Pratt County, Sec. 25 Twp. 26 Rge. 13W (E) (W)
Location as "NE/CNW&SW" or footage from lines NW NE NW
Lease Owner Wayne Kirkman
Lease Name Lunt Well No. 3
Office Address P.O. Box 143 Great Bend, Kansas 67530
Character of Well (completed as Oil, Gas or Dry Hole) oil
Date well completed 4-18 19 59
Application for plugging filed 4-24 19 74
Application for plugging approved 4- 19 74
Plugging commenced 5-14 19 74
Plugging completed 5-29 19 74
Reason for abandonment of well or producing formation

If a producing well is abandoned, date of last production 19
Was permission obtained from the Conservation Division or its agents before plugging was commenced? Yes

Name of Conservation Agent who supervised plugging of this well Russell Biberstein
Producing formation Depth to top Bottom Total Depth of Well 4394 1/2 Feet
Show depth and thickness of all water, oil and gas formations.

OIL, GAS OR WATER RECORDS

CASING RECORD

FORMATION	CONTENT	FROM	TO	SIZE	PUT IN	PULLED OUT
				5 1/2"		2,586'

Describe in detail the manner in which the well was plugged, indicating where the mud fluid was placed and the method or methods used in introducing it into the hole. If cement or other plugs were used, state the character of same and depth placed, from feet to feet for each plug set.

Plugged off bottom of hole with sand. Sand from 4394 1/2' to 4300'. Dumped 5 sx of cement. Squeezed well with 2 sx of Halls; 10 sx of Aqua gel; 100 sx of cement, filling to the bottom of the cellar.

RECEIVED
STATE CORPORATION COMMISSION
JUN 3 1974
CONSERVATION DIVISION
Wichita, Kansas

(If additional description is necessary, use BACK of this sheet)
Name of Plugging Contractor Art Lamb Casing Pulling Co.
Address 2809 King St. Hutchinson, Kansas 67501

STATE OF Kansas COUNTY OF Reno ss.
Art Lamb (employee of owner) or (owner or operator) of the above-described well, being first duly sworn on oath, says: That I have knowledge of the facts, statements, and matters herein contained and the log of the above-described well as filed and that the same are true and correct. So help me God.

(Signature) [Signature]
2809 King St. Hutchinson, Kansas 67501 (Address)

SUBSCRIBED AND SWORN TO before me this 29th day of May, 1974

My commission expires December 31, 1977

[Signature] Notary Public.

WELL LOG BUREAU—KANSAS GEOLOGICAL SOCIETY
508 East Murdock, Wichita, Kansas

15-151-10763-0001
COPY

Company—BEARDMORE-SUTTON-N.C.R.A.
Was Company—BIRMINGHAM-BARTLETT DRIG. CO.
Farm—Lunt No. 3
(Was Farnsworth #1)


SEC. 25 T. 26 R. 13W
NW NE NW

Total Depth. 4394½' ✓
Comm. 2-2-49
Shot or Treated.
Contractor. Birmingham-Bartlett
Issued. 4-18-59 ✓

DEEPENING RECORD:

Comp. 2-22-49

County Pratt
KANSAS

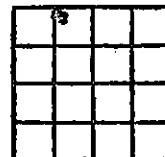

Elevation. 1935'

Production. DRY

CASING:

8 5/8" 304' w/250 sx cem.
5½" 4394' w/75 24

Figures Indicate Bottom of Formations.

surface soil, sand	40
sand, shells	260
shale, shells	385
red bed, shells	795
Anhydrite	820
shale, shell	1715
lime brkn	2470
shale, shells	2965
lime, shale	3255
lime	3315
lime, shale	3620
lime, sand	3650
lime	3665
shale	3712
lime brown	3716
shale	3722
lime	4112
shale	4135
shale, chert	4165
lime, chert	4199
chert, shale	4226
shale, Simpson sand	4255
lime sdy, shale	4270
shale	4303
lime	4307
shale	4334
lime	4365
Total Depth	

TOPS:

Anhydrite	795
Heebner	3536
Brown lime	3702
Lensing	3722
Mississippi	4095
Viola	4187
Simpson	4222
Arbuckle	4334

DEEPENING RECORD:

Comm. -5-23-55
Comp. -5-25-55

5½" 4394' w/75 sx cem.
Prod. - 111 BOPD
O.T.D. - 4365'
N.T.D. - 4394½'

lime 4394½'
Total Depth

TOPS: SCOUT
Simpson sand 4252

RECEIVED
STATE CORPORATION COMMISSION
MAY 28 1974
CONSERVATION DIVISION
Wichita, Kansas