

STATE OF KANSAS
STATE CORPORATION COMMISSION


WELL PLUGGING RECORD

Give All Information Completely
Make Required Affidavit
Mail or Deliver Report to:
Conservation Division
State Corporation Commission
800 Bitting Building
Wichita, Kansas

Pratt County. Sec. 26 Twp. 26S Rge. 13 ~~XXX~~ (W)

Location as "NE/CNW/SW" or footage from lines NW/4-NW/4-NE/4
Lease Owner Amerada Petroleum Corporation
Lease Name Anna Bruns "A" Well No. 1
Office Address Box 197 - Great Bend, Kansas
Character of Well (completed as Oil, Gas or Dry Hole) Oil
Date well completed September 15, 19 53
Application for plugging filed January 20, 19 58
Application for plugging approved January 22, 19 58
Plugging commenced February 3, 19 58
Plugging completed February 7, 19 58
Reason for abandonment of well or producing formation Unprofitable to operate

NORTH

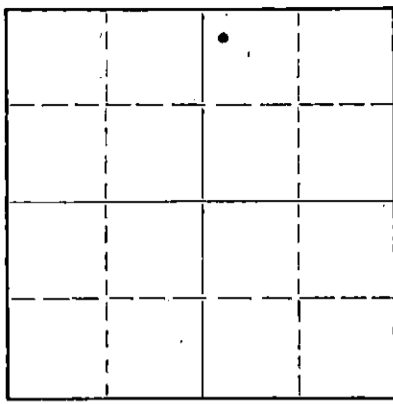

Locate well correctly on above
Section Plat

If a producing well is abandoned, date of last production January 14 19 58
Was permission obtained from the Conservation Division or its agents before plugging was commenced? Yes

Name of Conservation Agent who supervised plugging of this well Mr. Lackamp
Producing formation Viola-Simpson Depth to top _____ Bottom _____ Total Depth of Well 4380 Feet
Show depth and thickness of all water, oil and gas formations.

OIL, GAS OR WATER RECORDS

CASING RECORD

FORMATION	CONTENT	FROM	TO	SIZE	PUT IN	PULLED OUT
				8-5/8"	813'	0
				5-1/2"	4370'	3201'

Describe in detail the manner in which the well was plugged, indicating where the mud fluid was placed and the method or methods used in introducing it into the hole. If cement or other plugs were used, state the character of same and depth placed, from _____ feet to _____ feet for each plug set.

5 1/2" C.I. Bridge Plug Set @ 4100'. Dumped 1 Sax Cement from 4100' to 4092'.
5 1/2" C.I. Bridge Plug Set @ 3973'. Dumped 1 Sax Cement from 3973' to 3965'.
Plug back w/chat 3965' to 3917'. Load Hole w/70 Bbls. Water, dump 2 sax cement with Howco dump bailer 3917' to 3901'.
Shot off 5 1/2" Casing @ 3195' - Filled loose.
Cemented 8-5/8" Casing w/100 Sax Common Cement from 0' to 300'.
Set rock bridge and capped well with 5 sacks cement.

2-18-58

RECEIVED
STATE CORPORATION COMMISSION
FEB 18 1958
CONSERVATION DIVISION
Wichita, Kansas

(If additional description is necessary, use BACK of this sheet)

Name of Plugging Contractor Forbes Casing Pulling Company
Address Box 221 - Great Bend, Kansas

STATE OF Kansas, COUNTY OF Barton, ss.
Ernest Higgins (employee of owner) or ~~known operator~~ of the above-described well, being first duly sworn on oath, says: That I have knowledge of the facts, statements, and matters herein contained and the log of the above-described well as filed and that the same are true and correct. So help me God.

(Signature) Ernest Higgins
Box 197 - Great Bend, Kansas
(Address)

SUBSCRIBED AND SWORN TO before me this 18th day of February, 19 58

My commission expires November 8, 1960

Charles W. Anderson
Notary Public.

PLUGGING
FILE SEC 36 T. 26 R. 13W
BOOK PAGE 77 LINE 24

DRILLER'S LOG

Company: Amerada Petroleum Corp.

C NW NW NE
Sec. 26, Twp. 26S, Rge. 13W
County: Pratt,
Kansas

Farm: Anna Bruns "A" Well No. 1
Total Depth: 4380'

Comm: 8-25-53 Comp: 9-14-53
Contractor: Peel Brothers, Inc.

Elevation: —

Casing:
8 5/8 " 813' cem.
5 1/2 " 4370' cem.

Production:

Figures below indicate bottom of formations

Sand	200
Sand & Shale	650
Red Bed	800
Anhydrite	830
Red Bed & Shale	1315
Shale	1800
Lime & Shale	2265
Lime	2420
Lime & Shale	2725
Shale	2885
Lime & Shale	2990
Shale	3245
Lime & Shale	3360
Lime	3454
Lime & Shale	3540
Lime	3592
Shale	3702
Lime & Shale	3750
Lime	4060
Lime w/shale Streaks	4100
Lime	4380
Total Depth	4380

a copy of this log is needed to states of OK 9/21/53

SS Breccia & ...

2-18-58

This is to certify that the above information is to the best of my knowledge true and correct.

PEEL BROTHERS, INC.

BY: *H. B. Sutton*

SUBSCRIBED AND SWORN to before me this 16th day of September, 1953.

My commission expires January 9, 1957 *Cloris B. Welch*
Notary Public

2-18-58

PLUGGING
FILE SEC. 26 T. 26 R. 13W
BOOK PAGE 77 LINE 29