


STATE OF KANSAS
STATE CORPORATION COMMISSION
Give All Information Completely
Make Required Affidavit
Mail or Deliver Report to:
Conservation Division
State Corporation Commission
300 Bittling Building
Wichita, Kansas

WELL PLUGGING RECORD

NORTH

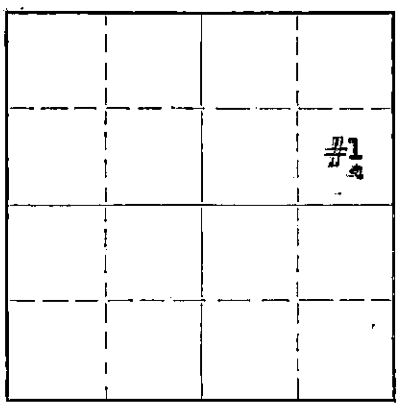

Locate well correctly on above Section Plat

Pratt County. Sec. 26 Twp. 26S Rge. 15W (E) (W)
Location as "NE/CNW $\frac{1}{4}$ SW $\frac{1}{4}$ " or footage from lines SE $\frac{1}{4}$ of SE $\frac{1}{4}$ of NE $\frac{1}{4}$
Lease Owner Amerada Petroleum Corp.
Lease Name Anna Bruns Well No. #1
Office Address Box 2040, Tulsa, Okla.
Character of Well (completed as Oil, Gas or Dry Hole) Dry Hole.
Date well completed Dec. 23, 19 49
Application for plugging filed Dec. 24, 19 49
Application for plugging approved Dec. 24, 19 49
Plugging commenced Dec. 24, 19 49
Plugging completed Dec. 24, 19 49
Reason for abandonment of well or producing formation Dry Hole.

If a producing well is abandoned, date of last production 19
Was permission obtained from the Conservation Division or its agents before plugging was commenced? Yes

Name of Conservation Agent who supervised plugging of this well Mr. Harold J. Hollis, Great Bend, Kansas.
Producing formation Depth to top Bottom Total Depth of Well 43.93' Feet
Show depth and thickness of all water, oil and gas formations.

OIL, GAS OR WATER RECORDS

CASING RECORD

Formation	Content	From	To	Size	Put In	Pulled Out
				8-5/8" OD	791'	None.

Describe in detail the manner in which the well was plugged, indicating where the mud fluid was placed and the method or methods used in introducing it into the hole. If cement or other plugs were used, state the character of same and depth placed, from feet to feet for each plug set.

Filled hole with heavy mud. Set Halliburton Plug at 250' down from top. Halliburton pumped in 15 sacks of regular cement through drill pipe on plug and filled hole to within 15' of top with heavy mud, set Halliburton Plug and dumped in 10 sacks of regular cement on plug, filling hole to top of surface casing in bottom of cellar as required by State Plugger Mr. Harold J. Hollis of Great Bend, Kansas. Well Plugged and Abandoned at 8:15 P.M. 12/24/49.

1-5-50
JAN 5 1950


(If additional description is necessary, use BACK of this sheet)

Correspondence regarding this well should be addressed to Amerada Petroleum Corp.
Address Box 2040
Tulsa, Okla.

STATE OF Oklahoma COUNTY OF Tulsa, ss.
J. B. Smith (employee of owner) or (owner or operator) of the above-described well,
being first duly sworn on oath, says: That I have knowledge of the facts, statements, and matters herein contained and the log of the above-described well as filed and that the same are true and correct. So help me God.
(Signature) J. B. Smith

SUBSCRIBED AND SWORN to before me this 3 day of January, 1950
Notary Public.

My commission expires January 17, 1951 22-5138-s 9-48-10M

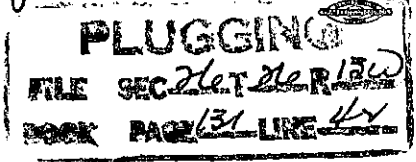

Well No. 1
 Farm Anna Bruns
 Elevation 1937' - Derrick Floor
 Location SE/4 SE/4 NE/4
 334' from South line
 331' from East line
 Section 26-26S-13W
 Pratt County, Kansas
 Company Amerada Petroleum Corporation
 Commenced Drlg. 12-5-49
 Completed Drlg. 12-22-49
 Contractor: Beardmore Drilling Co.
 Initial Production Dry Hole
 No Electric Log made.

CASING RECORD:	SIZE	WEIGHT	FLEET	CEMENT	PERFORATIONS
	8-5/8"	28#	791'	500 Sx	None

FORMATION:

Surface - Soil	0	45
Sand	45	255
Shale & Shells	255	395
Red Rock Shale	395	570
Sandy Shale	570	780
Anhydrite	780	810
Shale	810	1050
Shale & Shells	1050	1415
Shale & Salt	1415	1500
Salt and Shale	1500	1590
Shale & Lime	1590	1770
Broken Lime	1770	1830
Lime & Shale	1830	3520
Lime	3520	3570
Lime & Shale	3570	3680
Broken Lime	3680	3725
Lime	3725	4150
Lime & Chert	4150	4185
Cherty Lime	4185	4275
Sand	4275	4291
Lime	4291	4393
TOTAL DEPTH		4393'

GEOLOGICAL TOPS

Anhydrite (Driller's)	780'
Lansing	3740'
Marmaton	4085'
Mississippi	4149'
Viola	4182'
Simpson Shale	4245'
Simpson Sand	4271'
Arbuckle	4351'

Rotary tools used from 0' 4393'

1-18-50

PLUGGING
 FILE SEC. 26-T-26R-13W
 BOOK PAGE 13 LINE 48

RECEIVED
 JAN 18 1950
 STATE OF KANSAS
 COMMISSION