


STATE OF KANSAS
STATE CORPORATION COMMISSION
200 Colorado Derby Bldg.
Wichita, Kansas 67202

Form CP-4
Rev. 12-15-80

WELL PLUGGING RECORD

Give All Information Completely
Make Required Affidavit

COUNTY Pratt SEC. 36 TWP. 29S RGE. 14W /E/W
Location as in quarters or footage from lines:
C SE/4 NW/4

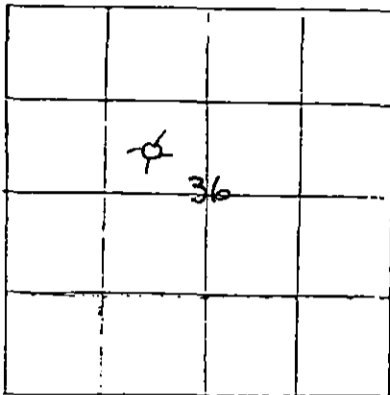

Locate Well
correctly on above
Section Platt.

Lease Owner Imperial Oil Company
Lease Name Benson Well No. 1-36
Office Address 720 Fourth Financial Center, Wichita, Ks. 67202
Character of Well (Completed as Oil, Gas or Dry Hole): Dry Hole
Date Well Completed November 30, 1983
Application for plugging filed November 30, 1983
Plugging commenced December 1, 1983
Plugging completed December 1, 1983
Reason for abandonment of well or producing formation D & A

Was permission obtained from the Conservation Division or it's
Agent's before plugging was commenced?

Name of Conservation Agent who supervised plugging of this well _____

Producing formation _____ Depth to top _____ bottom _____ T.D. 4,647'

Show depth and thickness of all water, oil and gas formations.

OIL, GAS OR WATER RECORDS Casing Record

Formation	Content	From	To	Size	Put in	Pulled Out
				8 5/8"	395'	-0-

Describe in detail the manner in which the well was plugged, indicating where the mud
fluid was placed and the method or methods used in introducing it into the hold. If cement
or other plugs were used, state the character of same and depth placed from _____ feet
to _____ feet for each plug set.

- Plug #1 @ 840' w/60 sx cement
- #2 @ 420' w/40 sx cement
- #3 @ 40' w/10 sx cement
- 10 sx cement in rathole
- 60/40 Pozmix

RECEIVED
STATE CORPORATION COMMISSION
DEC 7 1983
CONSERVATION DIVISION
Wichita, Kansas
12-7-83

(If additional description is necessary, use BACK of this sheet)
Name of Plugging Contractor Halliburton

STATE OF KANSAS COUNTY OF SEDGWICK, ss.

Robert C. Spurlock, Attorney-in-Fact (employee of owner) or (owner or operator) of the
above-described well, being first duly sworn on oath, says: That I have knowledge of the
facts, statements, and matters herein contained and the log of the above-described well as
filed and that the same are true and correct. So help me God.

(Signature) Robert C. Spurlock
720 Fourth Financial Center
(Address)

SUBSCRIBED AND SWORN TO before me this 6th day of December, 19 83

Barbara A. Waitt
Notary Public.

My Commission expires:

