

STATE OF KANSAS
STATE CORPORATION COMMISSION

Form CP-4

WELL PLUGGING RECORD

Give All Information Completely
Make Required Affidavit
Mail or Deliver Report to:
Conservation Division
State Corporation Commission
212 No. Market
Wichita, Kansas

Pratt County, Sec. 11 Twp. 29S Rge. 15 (E) W (W)

Location as "NE/CNW/SW" or footage from lines. SW NW

Lease Owner Charles R. King

Lease Name Winkley Well No. #1

Office Address 1527 Wichita Plaza, Wichita, Kansas

Character of Well (completed as Oil, Gas or Dry Hole) Dry Hole

Date well completed 6-30 19 66

Application for plugging filed 6-30 19 66

Application for plugging approved 6-30 19 66


Plugging commenced 6-30 19 66

Plugging completed 6-30 19 66

Reason for abandonment of well or producing formation Dry Hole

If a producing well is abandoned, date of last production 19

Was permission obtained from the Conservation Division or its agents before plugging was commenced? Yes

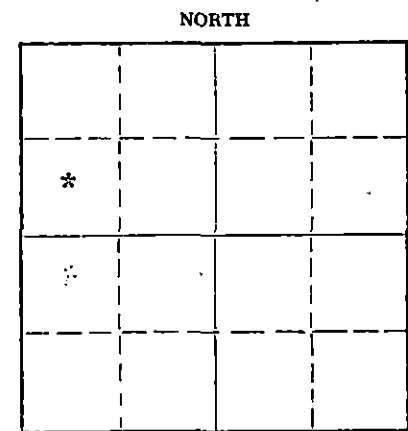

Locate well correctly on above Section Plat

Name of Conservation Agent who supervised plugging of this well Archie Ewing- Pratt, Kansas

Producing formation Depth to top Bottom Total Depth of Well 4857 Feet

Show depth and thickness of all water, oil and gas formations.

OIL, GAS OR WATER RECORDS

CASING RECORD

FORMATION	CONTENT	FROM	TO	SIZE	PUT IN	PULLED OUT
Surface Pipe		0	327	8 5/8"	327	-0-

Describe in detail the manner in which the well was plugged, indicating where the mud fluid was placed and the method or methods used in introducing it into the hole. If cement or other plugs were used, state the character of same and depth placed, from feet to feet for each plug set.

Filled hole with heavy mud

#1 plug at 300' w/25 sks. cement

#2 plug at 40' w/10 sks. cement

#3 plug in rathole w/2 sks. cement

RECEIVED
STATE CORPORATION COMMISSION

JUL 8 1966

7-8-66
CONSERVATION DIVISION
WICHITA, KANSAS

(If additional description is necessary, use BACK of this sheet)

Name of Plugging Contractor S & S Drilling Company

Address Box 645 Great Bend, Kansas 67530

STATE OF Kansas COUNTY OF Barton, ss.

T. D. Sweetman (employee of owner) or (owner or operator) of the above-described

well, being first duly sworn on oath, says: That I have knowledge of the facts, statements, and matters herein contained and the log of the above-described well as filed and that the same are true and correct. So help me God.

(Signature) T. D. Sweetman

Box 645, Great Bend, Kansas 67530 (Address)

SUBSCRIBED AND SWORN TO before me this 6th day of July, 1966

My commission expires May 9, 1967

Notary Public.

WELL LOG
Winkley #1
SW NW 11-29S-15W
Pratt County, Kansas

<u>FROM</u>	<u>TO</u>		<u>Elevation: 2019' K. B.</u>
00	180	Sand	
180	331	Shale & Shells	<u>Geological Tops:</u>
331	895	Red Bed & Shale	Anhydrite 995'
895	910	Anhydrite	Chase 2253'
910	2035	Shale	Heebner 3888'
2035	2255	Lime & Shale	LKC 4062'
2255	2535	Lime	BKC 4433'
2535	2815	Lime & Shale	Marmaton 4448'
2815	3305	Shale & Lime	Conglomerate 4524'
3305	3772	Lime & Shale	Viola 4659'
3772	4040	Shale & Lime	Simpson sh 4730'
4040	4538	Lime	Simpson sand 4759'
4538	4565	Lime & Chert	Arbuckle 4849'
4565	4629	Lime	T.D. 4857'
4629	4718	Lime & Chert	
4718	4849	Lime & Sand	
4849	4857	Lime	
4857		Total depth	

RECEIVED
STATE CORPORATION COMMISSION

JUL 8 1966

7-8-66

CONSERVATION DIVISION
Wichita, Kansas

STATE OF KANSAS

COUNTY OF BARTON ss

T. D. Sweetman, Partner of S & S Drilling Company, being first duly sworn on oath says: That I have knowledge of the facts, statements and matters herein contained and the log of the above described well as filed and that the same are true and correct.

T. D. Sweetman

T. D. Sweetman

Subscribed and sworn before me this 6th day of July, 1966.

Dick B. Casius

Notary Public Barton County

My Commission Expires 5/9/67