


STATE OF KANSAS
STATE CORPORATION COMMISSION

WELL PLUGGING RECORD

Give All Information Completely
Make Required Affidavit
Mail or Deliver Report to:
Conservation Division
State Corporation Commission
212 No. Market
Wichita, Kansas

Pratt County, Sec. 35 Twp. 29S Rge. 14 (E) W (W)
Location as "NE/CNW/SW" or footage from lines SW SE SE
Lease Owner Bowers Drilling Company
Lease Name Shriver S/B Shriver Well No. #1
Office Address 1434 Wichita Plaza; Wichita, Kansas 67202
Character of Well (completed as Oil, Gas or Dry Hole)
Date well completed _____ 19____
Application for plugging filed July 19 69
Application for plugging approved July 19 69
Plugging commenced August 1 19 69
Plugging completed August 6 19 69
Reason for abandonment of well or producing formation _____

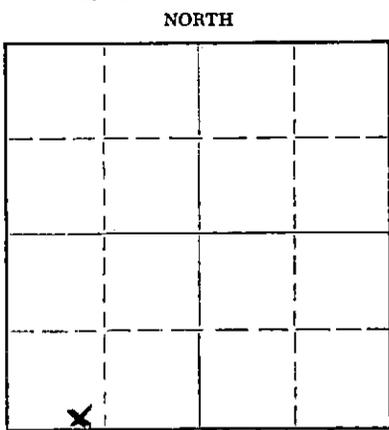

Locate well correctly on above Section Plat

If a producing well is abandoned, date of last production _____ 19____
Was permission obtained from the Conservation Division or its agents before plugging was commenced? Yes

Name of Conservation Agent who supervised plugging of this well Ralph Warren
Producing formation _____ Depth to top _____ Bottom _____ Total Depth of Well _____ Feet
Show depth and thickness of all water, oil and gas formations.

OIL, GAS OR WATER RECORDS

CASING RECORD

FORMATION	CONTENT	FROM	TO	SIZE	PUT IN	PULLED OUT
				8 5/8	395	None
				4 1/2	4091	2157
RECEIVED STATE CORPORATION COMMISSION AUG 29 1969 CONSERVATION DIVISION Wichita, Kansas						

Describe in detail the manner in which the well was plugged, indicating where the mud fluid was placed and the method or methods used in introducing it into the hole. If cement or other plugs were used, state the character of same and depth placed, from _____ feet to _____ feet for each plug set.

8 - 1 - 69 Dumped sand to 2500'. Mixed and dumped 4 sx of cement to 2450', to plug off bottom.
8 - 6 - 69 Set 10' rock bridge from 270' to 280'. Mixed and dumped 25 sx of cement. Mudded casing (8 5/8) to 40'. Set 10' rock bridge from 40' to 30'. Mixed and dumped 10 sx of cement from 30' to base of cellar.

RECEIVED
STATE CORPORATION COMMISSION
9-3-69 SEP 3 1969
CONSERVATION DIVISION
Wichita, Kansas

(If additional description is necessary, use BACK of this sheet)

Name of Plugging Contractor Russ Casing Pulling, Inc.
Address P. O. Box 1082 Great Bend, Kansas

STATE OF KANSAS, COUNTY OF SEDGWICK, ss.
Emil E. Bowers (employee of owner) or (owner or operator) of the above-described well, being first duly sworn on oath, says: That I have knowledge of the facts, statements, and matters herein contained and the log of the above-described well as filed and that the same are true and correct. So help me God.


(Signature) Emil E. Bowers

1434 Wichita Plaza, Wichita, Kansas
(Address)

SUBSCRIBED AND SWORN TO before me this 29th day of August, 19 69

Carole A. Young
Notary Public.

My commission expires May 12, 1973

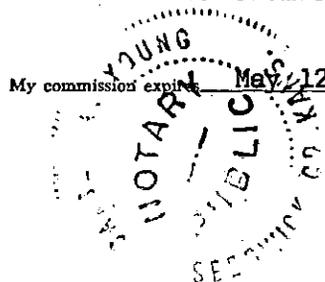

WELL LOG

COMPANY: BOWERS DRILLING COMPANY, INC.
CONTRACTOR: BOWERS DRILLING COMPANY, INC.
FARM: Shriver #1
LOCATION: 150' E. of SW SE SE Sec 35-29S-14W
Pratt County, Kansas
COMMENCED: 12-19-67
COMPLETED: 1-1-68
ELEVATION: 1968 Kelly Bushing

0 - 365	Rock, Sand	
365 - 395	Cement	
395 - 580	Red Bed	8-5/8" set at 395 W/250 sax
580 - 1580	Shale & Red Bed	
1580 - 1980	Shale & Shells	
1980 - 2600	Lime	
2600 - 4005	Lime & Shale	
4005 - 4040	Lime	
4040 - 4092*	Lime & Shale	4-1/2" set at 4091 W/350 sax
4040 -	T.D.	

* Hole deepened to 4092 after logging.

LOG TOPS

Krider	2156 (-188)
Winfield	2216 (-248)
Towanda	2286 (-318)
Florence	2371 (-403)
Council Grove	2491 (-523)
Cottonwood	2634 (-666)
Neva	2692 (-724)
Foraker	2797 (-829)
Wabaunsee	2966 (-996)
Langdon Sand	3032 (-1064)
Tarkio	3098 (-1130)
Emporia	3149 (-1181)
Burlingame	3238 (-1270)
Howard	3278 (-1310)
Topeka	3410 (-1442)
Heebner	3766 (-1798)
Toronto	3785 (-1817)
Douglas	3808 (-1840)
Brown Lime	3941 (-1973)
Lansing	3955 (-1987)
L.T.D.	4041

ST. JOHN
COMMISSION
JUL 24 1969
CONSERVATION DIVISION
Wichita, Kansas

STATE OF KANSAS)
) SS
COUNTY OF SEDGWICK)

I, Emil E. Bowers, do hereby certify that the above and foregoing is a true and correct copy of the log of the Shriver #1 located 150' E. of SW SE SE of Section 35-29S-14W Pratt County, Kansas, as reflected by the files of Bowers Drilling Company, Inc.

Emil E. Bowers



and sworn to before me, a Notary Public, in and for the State of Kansas this 24th day of January, 1968.

Elaine Reichenberger
Elaine Reichenberger, Notary Public

My Commission expires November 16, 1971.