

STATE OF KANSAS
STATE CORPORATION COMMISSION

WELL PLUGGING RECORD

Give All Information Completely
Make Required Affidavit
Mail or Deliver Report to:
Conservation Division
State Corporation Commission
800 Bittling Building
Wichita, Kansas

Pratt County. Sec. 35 Twp. 29 Rge. (E) 14 (W)

Location as "NE/CNW $\frac{1}{4}$ SW $\frac{1}{4}$ " or footage from lines SW NE SE

Lease Owner Cities Service Oil Co.

Lease Name Shriver "B" Well No. 2

Office Address Bartlesville, Oklahoma

Character of Well (completed as Oil, Gas or Dry Hole) Dry hole.

Date well completed October 9, 1949

Application for plugging filed October 12, 1949

Application for plugging approved October 13, 1949

Plugging commenced October 15, 1949

Plugging completed October 15, 1949

Reason for abandonment of well or producing formation Dry hole.

If a producing well is abandoned, date of last production 19

Was permission obtained from the Conservation Division or its agents before plugging was commenced? Yes

Name of Conservation Agent who supervised plugging of this well Mr. C. D. Stough

Producing formation Arbuckle Depth to top 4645' Bottom 4675' Total Depth of Well 4675' Feet

Show depth and thickness of all water, oil and gas formations.

OIL, GAS OR WATER RECORDS

CASING RECORD

Formation	Content	From	To	Size	Put In	Pulled Out
				8-5/8"	411'	None

Describe in detail the manner in which the well was plugged, indicating where the mud fluid was placed and the method or methods used in introducing it into the hole. If cement or other plugs were used, state the character of same and depth placed, from.....feet to.....feet for each plug set.

4675' to 250' heavy mud.
250' to 200' wood plug and 15 sacks cement.
200' to 35' mud and soil.
35' to base of cellar - wood plug and 10 sacks cement.

RECEIVED
OCT 27 1949
STATE CORPORATION COMMISSION
WICHITA, KANSAS


Correspondence regarding this well should be addressed to Mr. R. C. Cooper
Address Box 751
Great Bend, Kansas

STATE OF Kansas, COUNTY OF Barton, ss.
V. M. Conover (employee of owner) or (owner or operator) of the above-described well,
being first duly sworn on oath, says: That I have knowledge of the facts, statements, and matters herein contained and the log of the above-described well as filed and that the same are true and correct. So help me God.

(Signature) V. M. Conover
Box 751, Great Bend, Kansas
(Address)

SUBSCRIBED AND SWORN to before me this 19th day of October, 1949
N. J. Smith
Notary Public.

My commission expires March 12, 1951

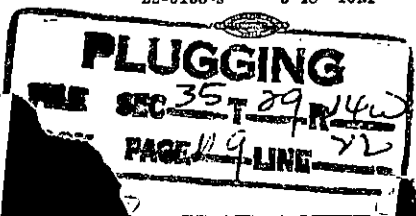

WELL RECORD

Company Cities Service Oil Co. Well No. 2 Farm Shriver "B"
 Location 990' South and 990' West of E/4 Corner Sec. 35 T. 29 R. 14W
 Elevation 1970 (1968 Gr.) County Pratt State Kansas
 Drlg. Comm. September 22, 1949 Contractor R. W. Fine Drilling Company
 Drlg. Comp. October 8, 1949 Acid None
 T. D. 4675' Initial Prod. None - Dry Hole. P. & A. 10-10-49

CASING RECORD:

8-5/8" 410' con. 250 ex' cement,
 300# C. C. & 125# Fluocel

FORMATION RECORDED:

clay, sand & red rock	0-411
red bed	920
salt & shale	970
shale & salt	1490
shale, shells & lime	1975
lime & shale	2150
shale & lime	2260
lime & shale	2550
shale & lime	2640
lime & shale	2935
shale	3020
lime & shale	3425
sand & shale	3560
shale	3605
lime & shale	3790
shale	3885
lime & shale	4100
lime	4295
lime & shale	4334
lime	4411
lime & shale	4440
shale	4494
lime & shale	4498
cored conglomerate (shale & chert) rec. 1 1/2'	4503
chert & lime	4537
shale & sand	4552
sand & shale	4590
shale	4623
lime & shale	4645
lime	4675 P. D.

Top Lansing	3977'
Top Cherty Conglomerate	4437'
Top Viola	4504'
Top Simpson Shale	4531'
Top Simpson Sand	4548'
Top Arbuckle	4645'
Penetration	30'
Total Depth	4675'

Drill stem test 4549-63, recovered
 180' gas-cut mud and 690' salt
 water in 15 mins.

SYFO: 500' OK
 1000' OK
 1500' OK
 2000' OK
 2500' 2°
 3800' OK

PLUGGING

FILE SEC T R

BOOK PAGE LINE

RECEIVED

OCT 27 1949
 STATE CORPORATION
 COMMISSION
 KANSAS