

STATE OF KANSAS  
STATE CORPORATION COMMISSION


WELL PLUGGING RECORD

Give All Information Completely  
Make Required Affidavit  
Mail or Deliver Report to:  
Conservation Division  
State Corporation Commission  
800 Bittling Building  
Wichita, Kansas

OR  
FORMATION PLUGGING RECORD

Strike out upper line  
when reporting plug-  
ging off formations.

NORTH

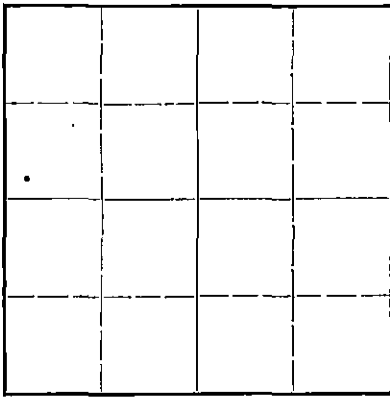

Locate well correctly on above  
Section Flat

Pratt County. Sec. 35 Twp. 29 Rge. (E) 14 (W)  
Location as "NE 1/4 NW 1/4 SW 1/4" or footage from lines 330' North 330' East of W/4 Corner  
Lease Owner: Cities Service Oil Company  
Lease Name: Bergner Well No. 1  
Office Address: Bartlesville, Oklahoma  
Character of Well (completed as Oil, Gas or Dry Hole): Dry hole.  
Date well completed: July 23 19 47  
Application for plugging filed: July 23 19 47  
Application for plugging approved: July 23 19 47  
Plugging commenced: July 24 19 47  
Plugging completed: July 24 19 47  
Reason for abandonment of well or producing formation: Dry hole.

If a producing well is abandoned, date of last production 19  
Was permission obtained from the Conservation Division or its agents before plugging was com-  
menced? Yes.

Name of Conservation Agent who supervised plugging of this well: H. W. Kerr  
Producing formation: Arbuckle Depth to top: 4629' Bottom: 4674' Total Depth of Well: 4674' Feet  
Show depth and thickness of all water, oil and gas formations.

OIL, GAS OR WATER RECORDS

CASING RECORD

Formation	Content	From	To	Size	Put In	Pulled Out
				8-5/8"	755	None

Describe in detail the manner in which the well was plugged, indicating where the mud fluid was placed and the method or methods used in introducing it into the hold. If cement or other plugs were used, state the character of same and depth placed, from feet to feet for each plug set.

Heavy mud 4674' to 250'  
Wood plug & 15 sacks cement from 250' to 195'  
Mud and soil 195' to 35'  
10 sacks cement 35' to Base of cellar

Rec'd  
8-22-47  
22 1947

(If additional description is necessary, use BACK of this sheet)


Correspondence regarding this well should be addressed to: V. M. Conover  
Address: Box 751  
Great Bend, Kansas

STATE OF Kansas, COUNTY OF Barton, ss.  
V. M. Conover (employee of owner) or (owner or operator) of the above-described well,  
being first duly sworn on oath, says: That I have knowledge of the facts, statements, and matters herein contained and the log of the above-described well as filed and that the same are true and correct. So help me God.

(Signature) V. M. Conover  
Box 751, Great Bend, Kansas  
(Address)

SUBSCRIBED AND SWORN to before me this 28th day of July 19 47  
N. J. Smith  
Notary Public.

My commission expires 3-12-51

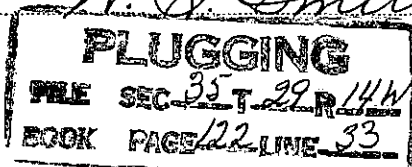

WELL RECORD

Company Citizen Service Oil Co. et al. Well No. 1 Farm Harrier  
 Location 330' North and 320' East of W/4 Corner Sec. 35 T 29 R. 14W  
 Elevation 1954 (1951 Cr.) County Pratt State Kansas  
 Drig. Comm. June 20, 1947 Contractor Corbett-Barbour Drilling Company  
 Drig. Comp. July 23, 1947 Acid None  
 T. D. 4674' Initial Prod. None - Dry Hole. P. & A. 7-24-47

CASING RECORD:

8-5/8" C 736' com. with 450 sticks com.

FORMATION RECORD:

sand & gravel	0-180
red bed	370
sand & red bed	750
sand & streaks anhydrite	750
anhydrite	730
shale & shells	2015
shale & lime	2295
lime	3000
lime & shale	3115
shale & lime	3160
lime & shale	3190
lime	4525
cherty lime	4530
lime, shale & sand	4543
sand	4572
sand & shale	4615
sand	4631
sand & lime	4667
lime	4674 T. D.

Top Lansing	3976'
Top Viola	4494'
Top Simpson Shale	4536'
Top Simpson Sand	4538'
Top Arbuckle	4689'
Penetration	45'
Total Depth	4674'

Drill stem test 4496-4525, recovered 60' rotary mud in 30 mins.

Drill stem test 4539-54, recovered 60' mud in 30 mins.

Drill stem test 4557-72, recovered 2160' salt water in 30 mins. B. H. P. 1400#.

SAYO:

500'	1°
1000'	0°
1500'	1°
2000'	0°
2500'	1°
3000'	0°
3500'	0°
4100'	0°

7-7/8" rotary hole.

STATE OF KANSAS  
 COMMISSIONER  
 8-22-47  
 22 1947

**PLUGGING**  
 FILE SEC 35 T 29 R 14W  
 BOOK PAGE 122 LINE 23