


STATE OF KANSAS  
STATE CORPORATION COMMISSION

WELL PLUGGING RECORD

Give All Information Completely  
Make Required Affidavit  
Well or Deliver Report to:  
Conservation Division  
State Corporation Commission  
800 Bittling Building  
Wichita, Kansas

NORTH

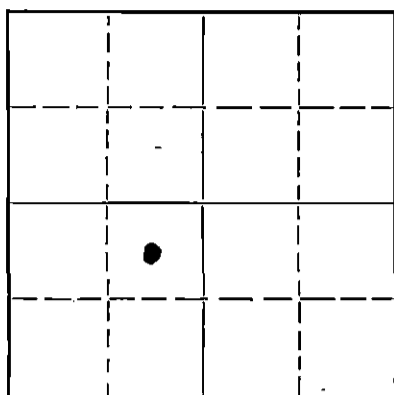

Locate well correctly on above  
Section Plat

Reno County. Sec. 6 Twp. 21. Rge. 10 (E) W (W)  
Location as "NE/CNW<sup>1</sup>/<sub>4</sub>SW<sup>1</sup>/<sub>4</sub>" or footage from lines 125' North of CNE SW  
Lease Owner The Lotus Oil Company  
Lease Name Volker Well No. 2  
Office Address 900 Land Bank Bldg., Kansas City, Mo.  
Character of Well (completed as Oil, Gas or Dry Hole) Oil Well  
Date well completed 3-10-43 19. 43  
Application for plugging filed October 10, 19. 51  
Application for plugging approved October 10, 19. 51  
Plugging commenced October 17 19. 51  
Plugging completed October 29 19. 51  
Reason for abandonment of well or producing formation No production  
Test shows no fluid in well  
If a producing well is abandoned, date of last production September 19. 51  
Was permission obtained from the Conservation Division or its agents before plugging was commenced? yes

Name of Conservation Agent who supervised plugging of this well Ruel Durkee  
Producing formation Mi sener Depth to top Bottom Total Depth of Well 3728 Feet  
Show depth and thickness of all water, oil and gas formations.

OIL, GAS OR WATER RECORDS

CASING RECORD

Formation	Content	From	To	Size	Put In	Pulled Out
Surface		0	255'	8"	255'	None
		0	3721'	5 1/2" O.D.	3721'	2982.76'

Describe in detail the manner in which the well was plugged, indicating where the mud fluid was placed and the method or methods used in introducing it into the hole. If cement or other plugs were used, state the character of same and depth placed, from feet to feet for each plug set.

Total Depth 3728'  
Sand 2728'-3715'  
6 Sacks cement 3715'-3665'  
Heavy Mud 3665'-260'  
Rock Bridge 260'-250'  
15 Sacks cement 250'-200'  
Heavy Mud 200'-10'  
5 Sacks cement to base of cellar

(If additional description is necessary, use BACK of this sheet)

Name of Plugging Contractor Walker Drilling Inc.  
Address 211 West 9th, Hutchinson, Kansas

STATE OF Kansas, COUNTY OF Reno, ss.  
Walker Drilling Inc. (employee of owner) or (owner or operator) of the above-described well,  
being first duly sworn on oath, says: That I have knowledge of the facts, statements, and matters herein contained and the log of the above-described well as filed and that the same are true and correct. So help me God. Walker Drilling Inc.

(Signature) Robert J Walker  
211 W 9th Hutchinson Kansas  
(Address)

SUBSCRIBED AND SWORN to before me this 5 day of Nov, 1951

Oscar A. Huber  
Notary Public.

My commission expires Commission Expires October 31, 1953 23-8390-6-51-20M

PLUGGING  
FILE SEC-6 T-3 R-10  
BOOK PAGE 114 LINE 21

RECEIVED  
NOV-6-51  
CONSERVATION DIVISION  
Wichita, Kansas


WELL LOG BUREAU - KANSAS GEOLOGICAL SOCIETY  
412 Union National Bk Bldg., Wichita, Kansas

PORTER-CARPENTER & LAY  
Volker No. 2.

SEC. 6 T. 24 R. 10 W  
CNE SW  
125' No. of CNE SW

Total Depth. 3728'  
Comm. 1-6-43 Comp. 3-10-43  
Shot or Treated.  
Contractor.  
Issued. 4-10-43

County. Reno

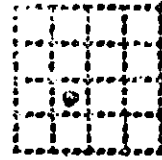

CASING:  
8" 255'  
5" 3721'

Elevation.

Production. Pot. 2803 B.

Figures Indicate Bottom of Formations.

clay & sand	160
shells & lime	165
red rock	225
red rock & shale	275
anhydrite	505
shale	620
shale & lime shells	1025
shale & lime shells	1305
shale	1390
lime	1410
shale	1425
lime brkn	1500
brkn lime & shale	1565
lime brkn	1755
shale & lime	1823
lime brkn	1900
lime	2030
shale & lime shells	2285
shale	2380
shale & lime shells	2455
shale & lime	2630
shale & lime shells	2710
lime brkn	2815
shale & lime	2835
lime	3140
lime brkn	3200
shale	3290
lime brkn	3320
shale & lime	3385
lime	3403
cherty lime & shale	3435
lime	3445
lime cherty	3465
lime	3570
lime brkn	3684
shale	3709
sand	3717
lime	3719
lime	3728
Total Depth.	

Sample Log:  
3709-15 sdy lime, g.s.o.  
3717 chert wh  
opalescent

Sample Tops:  
Misener 3709  
Viola 3717

6 24 10w.  
114 28..

LOG

(WELL LOG BUREAU)

PORTER-CARPENTER AND LAY

Sec. 6 T. 24, R. 10 W  
CNE SW  
125' No. of CNE SW

Volker No. 2

County, Reno, Kansas

Total Depth 3728'  
Comm. 1-16-43 Comp. 3-10-43  
Shot or Treated  
Contractor  
Issued 4-10-43

CASING:  
8" 255 Feet  
5" 3721'

Elevation \_\_\_\_\_

Production, Pot. 2803 Bbls

Figures Indicate Bottom of Formation


Clay and Sand	160
shells and Lime	165
red rock	225
red rock and shale	275
anhydrite	505
shale	620
shale and lime shells	1025
shale and lime shells	1305
shale	1390
lime	1410
shale	1425
lime brkn	1500
brkn lime and shale	1565
lime brkn	1755
shale and lime	1823
lime brkn	1900
lime	2030
shale and lime shells	2285
shale	2380
shale and lime shells	2455
shale and lime	2630
shale and lime shells	2710
lime brkn	2815
shale and lime	2835
lime	3140
lime brkn	3200
shale	3290
lime brkn	3320
shale and lime	3385
lime	3403
cherty lime and shale	3435
lime	3445
lime cherty	3465
lime	3570
lime brkn	3684
shale	3709
sand	3717
lime	3719
lime	3728
Total Depth	

Sample Log:  
3709 -15 sdy lime g.s.o.  
3717 chert wh opalescent

Sample Tops:  
Misener 3709  
Viola 3717

RECEIVED  
STATE CORPORATION COMMISSION  
OCT 29 1951  
CONSERVATION DIVISION  
Wichita, Kansas

FILED  
OCT 30 6 14 P.M. 1951  
WICHITA, KANSAS  
PAGE 14 LINE 27

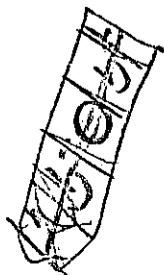

21108