


STATE OF KANSAS
STATE CORPORATION COMMISSION

WELL PLUGGING RECORD

Give All Information Completely
Make Required Affidavit
Mail or Deliver Report to:
Conservation Division
State Corporation Commission
800 Bittling Building
Wichita, Kansas

NORTH

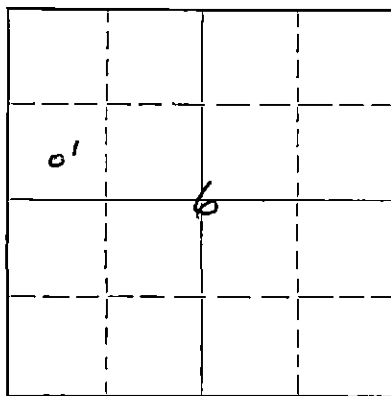

Locate well correctly on above
Section Plat

Reno County. Sec. 6 Twp. 24S Rge. 10 XXXX (W)
Location as "NE/CNW $\frac{1}{4}$ SW $\frac{1}{4}$ " or footage from lines C SW NW
Lease Owner Magnolia Petroleum Co.
Lease Name Newt Darr Well No. 1
Office Address Box 770, Great Bend, Kan.
Character of Well (completed as Oil, Gas or Dry Hole) Oil
Date well completed Jan. 10, 19 43
Application for plugging filed May 12, 19 51
Application for plugging approved May 14, 19 51
Plugging commenced May 21, 19 51
Plugging completed May 28, 19 51
Reason for abandonment of well or producing formation well temporarily abandoned
did not produce enough oil to pay to operate.
If a producing well is abandoned, date of last production January 19 50
Was permission obtained from the Conservation Division or its agents before plugging was commenced? Yes

Name of Conservation Agent who supervised plugging of this well Mr. Ruel Durkee
Producing formation Viola Depth to top 3708 Bottom 3719/DD to 3728 Total Depth of Well 3728 Feet
Show depth and thickness of all water, oil and gas formations.

OIL, GAS OR WATER RECORDS

CASING RECORD

| Formation | Content | From | To | Size | Put In | Pulled Out |
|-----------|---------|------|------|---------|--------|------------|
| Viola | Oil | 3708 | 3728 | 10-3/4" | 300' | None |
| | | | | 5 1/2" | 3699' | 2894' |

Describe in detail the manner in which the well was plugged, indicating where the mud fluid was placed and the method or methods used in introducing it into the hole. If cement or other plugs were used, state the character of same and depth placed, from _____ feet to _____ feet for each plug set.

Plugged bottom of hole w/river gravel from 3728' to 3603' & 6 sx cement from 3603' to 3585'; shot 5 1/2" csg. @ 3148', 3040' & 2894'; & pulled 2894' of 5 1/2" csg. Filled w/heavy mud to 250' & set rock bridge plug @ 250' & cemented w/20 sx cement to 190' & filled w/heavy mud to 15' & cemented base of cellar w/5 sx cement.

(If additional description is necessary, use BACK of this sheet)

Correspondence regarding this well should be addressed to Mr. C.A. Hill, Magnolia Petroleum Co.
Address Box 770, Great Bend, Kansas

STATE OF Kansas, COUNTY OF Barton, ss.
C.A. Hill (employee of owner) or (owner or operator) of the above-described well,

being first duly sworn on oath, says: That I have knowledge of the facts, statements, and matters herein contained and the log of the above-described well as filed and that the same are true and correct. So help me God.

(Signature) *C.A. Hill*
Box 770, Great Bend, Kan.
(Address)

SUBSCRIBED AND SWORN to before me this 8th day of June, 19 51

My commission expires October 15, 1953

PLUGGING
FILED SEG-6 T 24 R 107D
BOOK PAGE 11 LINE 36

RECEIVED
STATE CORPORATION COMMISSION
6-9-51
JUN - 9 1951
CONSERVATION DIVISION
Wichita, Kansas

MAGNOLIA PETROLEUM COMPANY

NEWT DARR #1
 C SW NW, Sec. 6-24S-10W
 Reno County, Kansas

LOG OF WELL

Plugging Started: May 21, 1951
 Plugging Completed: May 28, 1951

| CASING RECORD | PUT IN | PULLED OUT |
|---------------|--------|------------|
| 10-3/4" | 300' | None |
| 5 1/2" | 3699' | 2894' |

Well Plugged & Abd. by: Standard Pulling Co., Lyons, Kan. Elev: 1804'

| FORMATION: | TOP | BOTTOM |
|---|------|--------|
| Shale & shells | 0 | 860 |
| Set 300' of 10-3/4" csg @ 300' w/225 sx cem. circ | | |
| Red rock | 860 | 1060 |
| Salt & shale | 1060 | 1325 |
| Shale & shells | 1325 | 1615 |
| Lime | 1615 | 1980 |
| lime & shale | 1980 | 2310 |
| Shale & shells | 2310 | 2390 |
| Shale | 2390 | 2800 |
| Shale & lime | 2800 | 2935 |
| Shale | 2935 | 3015 |
| Lime | 3015 | 3270 |
| Shale | 3270 | 3365 |
| Lime | 3365 | 3665 |
| Shale | 3665 | 3698 |
| Top Misener Sand | 3698 | |
| Misener sand | 3698 | 3700 |
| Set 3699' of 5 1/2" csg @ 3699' w/150 sx cem. | | |
| Misener sand | 3700 | 3708 |
| Top Viola | 3708 | |
| Viola lime | 3708 | 3719 |

HISTORY OF COMPLETION:
 Acid w/2000 gals. F-80 BOPH 1/8" choke. 1/10/43 Max. Pot. by BHPG 3000 BOPD.
 12/8/45 DD to 3723' - P 97 BO & 20 BWPD
 2/8/47 DD to 3728' - P 25 BO & 12 BWPD.

PLUGGING RECORD:
 Plugged btm of hole w/river gravel from 3728' to 3603' & 6 sx cem from 3603' to 3585'; shot 5 1/2" csg. @ 3148', 3040' & 2894'; & pulled 2894' of 5 1/2" csg. Filled w/heavy mud to 250', & set rock bridge plug @ 250' & cem w/20 sx cem. to 190' & filled w/heavy mud to 15' & cem. base of cellar w/5 sx cement.

PLUGGING
 FILE SEC 6T 24R 10W
 BOOK PAGE 81 LINE 36

RECEIVED
 STATE CORPORATION COMMISSION
 JUN - 9 1951
 CONSERVATION DIVISION
 Wichita, Kansas

