

STATE OF KANSAS  
STATE CORPORATION COMMISSION

Form CP-4

Give All Information Completely  
Make Required Affidavit  
Mail or Deliver Report to:  
Conservation Division  
State Corporation Commission  
212 No. Market  
Wichita, Kansas


WELL PLUGGING RECORD

660'S & 660'W of E/4

Reno County, Sec. 6 Twp. 24S Rge. (E) 10 (W)

Location as "NE/CNW&SWK" or footage from lines \_\_\_\_\_  
Lease Owner Independent Lease Management Co.  
Lease Name Freeman Well No. 3  
Office Address 800 Wichita Plaza  
Character of Well (completed as Oil, Gas or Dry Hole) Oil  
Date well completed \_\_\_\_\_ 19\_\_\_\_  
Application for plugging filed April 16 19 69  
Application for plugging approved April 17 19 69  
Plugging commenced April 25 19 69  
Plugging completed May 3 19 69  
Reason for abandonment of well or producing formation \_\_\_\_\_

NORTH

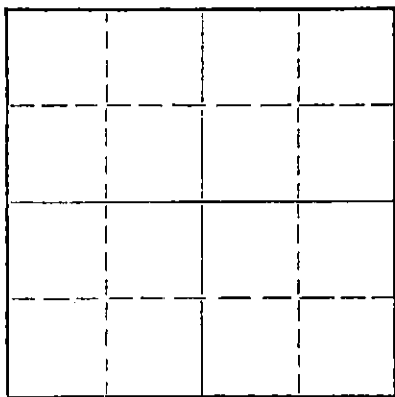

Locate well correctly on above  
Section Plat

If a producing well is abandoned, date of last production \_\_\_\_\_ 19\_\_\_\_  
Was permission obtained from the Conservation Division or its agents before plugging was commenced? Yes

Name of Conservation Agent who supervised plugging of this well \_\_\_\_\_  
Producing formation \_\_\_\_\_ Depth to top \_\_\_\_\_ Bottom \_\_\_\_\_ Total Depth of Well \_\_\_\_\_ Feet  
Show depth and thickness of all water, oil and gas formations.

OIL, GAS OR WATER RECORDS

CASING RECORD

FORMATION	CONTENT	FROM	TO	SIZE	PUT IN	PULLED OUT
				8-5/8"	270	
				5-1/2"	3725	2933

Describe in detail the manner in which the well was plugged, indicating where the mud fluid was placed and the method or methods used in introducing it into the hole. If cement or other plugs were used, state the character of same and depth placed, from \_\_\_\_\_ feet to \_\_\_\_\_ feet for each plug set.

Sand 3730'-3690'  
5 sacks cement @ 3690'  
Shot pipe @ 3115', 3034' & 2924'  
Pulled 2933' 5 1/2' casing  
Bridge @ 260'  
Rock 260-250'  
25 sacks cement @ 250'  
Mud to 40'  
Rock 40-30'  
10 sacks cement 30' to 4' under surface.

RECEIVED  
STATE CORPORATION COMMISSION  
MAY 22 1969 5-22-69  
CONSERVATION DIVISION  
Wichita, Kansas

Plugging complete

(If additional description is necessary, use BACK of this sheet)

Name of Plugging Contractor Braden-Deem, Inc.  
Address 210 One Twenty Bldg., Wichita, Kansas 67202

STATE OF Kansas, COUNTY OF Sedgwick, ss.  
Doy C. Deem (employee of owner) or (owner or operator) of the above-described well, being first duly sworn on oath, says: That I have knowledge of the facts, statements, and matters herein contained and the log of the above-described well as filed and that the same are true and correct. So help me God.

(Signature) \_\_\_\_\_  
210 One Twenty Bldg., Wichita, Kansas  
(Address)

SUBSCRIBED AND SWORN TO before me this 21 day of May, 19 69

My commission expires March 21, 1970

Notary Public.

WELL RECORD

Company Cities Service Oil Company Well No. 3 Farm Freeman  
 Location 660' South and 660' West of E/4 Corner Sec. 6 T. 24 R. 10W  
 Elevation 1798 County Keno State Kansas  
 Drlg. Comm. July 26, 1943 Contractor Corbett-Barbour Drilling Company  
 Drlg. Comp. August 9, 1943 Acid 1000 gals. 8-30-43  
 T. D. 3730 Initial Prod. B. H. P. Gauge Potential: 3000 oil, no water, 24 hrs.  
 (Ind. Cap. 37,547 bbls.)

CASING RECORD:

8-5/8" @ 270' with 150 sx cement  
 5-1/2" @ 3725' com. 100 sx Ideal

FORMATION RECORD:

sand	0-150
red bed, shale & sand	270
red bed	475
anhydrite	505
shale & shells	1380
broken lime & shale	1510
broken lime	1625
lime & shale	1710
lime	2000
shale & shells	2090
lime & shale	2365
shale & lime	2600
shale	2690
lime	2790
shale & lime	2890
lime	3241
shale & lime	3345
lime	3567
lime & shale	3645
lime	3665
shale	3707
sand	3724
lime	3734

3734 Rot. TD = 3730 SLM (T.D.)

Corr. Top Viola 3720'  
 Penetration 10'  
 Total Depth 3730'

Loaded hole with 1200' water before drilling shoe; cleaned out to bottom 3730; good show oil and gas.

Syfo: 500'  
 1000'  
 1500'  
 2000'  
 2500'  
 3000'  
 3500'

RECEIVED  
 STATE CORPORATION COMMISSION  
 APR 17 1969  
 CONSERVATION DIVISION  
 Wichita, Kansas

Workover: 3/20/1968:

P.B. to 3718 up Lane Wells bridge plug perforated Meisner sand 3706'-3709'; non-productive

To the best of my knowledge the above facts are true as stated.

Dale P. Jewett Dale P. Jewett  
 Subscribed and sworn to before me this 15th day of April, 1969.

Reynold E. Craytor  
 Notary Public

My commission expires:  
 June 9, 1969.  
 Sedgwick County  
 State of Kansas

36  
 12/25  
 1/10/5