

STATE OF KANSAS  
STATE CORPORATION COMMISSION

WELL PLUGGING RECORD

Give All Information Completely  
Make Required Affidavit  
Mail or Deliver Report to:

OR  
FORMATION PLUGGING RECORD

Strike out upper line  
when reporting plugging  
off formations.

Conservation Division  
State Corporation Commission  
800 Bittling Building  
Wichita, Kansas

Stafford County, Sec 26 Twp 24 Rge 11 (W)

NORTH 11W

Location as "NE 1/4 NW 1/4 SW 1/4" or footage from lines NW 1/4 - SW 1/4 - NE 1/4

Lease Owner Stanolind Oil and Gas Company

Lease Name Fred H. Paulsen Well No 1

Office Address Box 591, Tulsa, Oklahoma

Character of Well (Completed as Oil, Gas or Dry Hole) Dry Hole

Date, well completed May 6, 1938

Application for plugging filed April 5, 1939

Application for plugging approved April 5, 1939

Plugging Commenced April 5, 1939

Plugging Completed April 10, 1939

Reason for abandonment of well or producing formation Dry Hole

If a producing well is abandoned, date of last production 193

Was permission obtained from the Conservation Division or its agents before plugging was commenced? Yes

Name of Conservation Agent who supervised plugging of this well Guy Wiershing

Producing formation None Depth to top Bottom Total Depth of Well 4020 Feet

Show depth and thickness of all water, oil and gas formations.

OIL, GAS OR WATER RECORDS


CASING RECORD

Formation	Content	From	To	Size	Put In	Pulled Out
Misener Zone	Show Oil & Gas Water	3821	3837	10-3/4" OD 7" OD	279' 3" 3846' 9"	None 1869

Describe in detail the manner in which the well was plugged, indicating where the mud fluid was placed and the method or methods used in introducing it into the hole. If cement or other plugs were used, state the character of same and depth placed, from...feet to...feet for each plug set.

Filled with mud from 3835 to 4020 and then dumped 15 sacks cement. Ripped 7" OD at 1875' and pulled 1869'. Filled hole with mud. Dumped 15 sacks of cement at bottom of surface pipe, filled with mud and dumped 10 sacks of cement at top of string.

PLUGGING  
FILE SEC 26 TWP 24 RGE 11 W  
BOOK PAGE 57 LINE 10

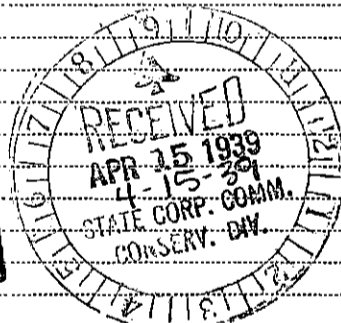

(If additional description is necessary, use BACK of this sheet)

Correspondence regarding this well should be addressed to Stanolind Oil and Gas Company  
Address P. O. Box 485, Stafford, Kansas

STATE OF \_\_\_\_\_, COUNTY OF \_\_\_\_\_, ss.

\_\_\_\_\_ (employee of owner) or (owner or operator) of the above-described well, being first duly sworn on oath, says: That I have knowledge of the facts, statements, and matters herein contained and the log of the above-described well as filed and that the same are true and correct. So help me God.

(Signature) *W.B. Snyder*

(Address)

SUBSCRIBED AND SWORN to before me this 13th day of April, 1939

My commission expires September 14, 1942

*J. Young*  
Notary Public.

640 Acres

N. 24 11W

# STANOLIND OIL AND GAS COMPANY WELL RECORD

160					160
		0	61		
		26			
160					160

Locate Well Correctly

T  
24  
S


COUNTY Stafford, SEC. 26, TWP. 24s, RGE. 11w  
 COMPANY OPERATING Stanolind Oil and Gas Company  
 OFFICE ADDRESS Box 591 - Tulsa, Oklahoma  
 FARM NAME F. Paulsen WELL NO. 1  
 DRILLING STARTED 3-6 1938, DRILLING FINISHED 5-6 1938  
 WELL LOCATED NE  $\frac{1}{4}$  SW  $\frac{1}{4}$  NE  $\frac{1}{4}$  990 ft. North of South  
 Line and 330 ft. East of West Line of Quarter Section.  
 ELEVATION (Relative to sea level) DERRICK FLR. 1787 GROUND 1781  
 CHARACTER OF WELL (Oil, gas or dry hole) Dry hole

### OIL OR GAS SANDS OR ZONES

Name	From	To	Name	From	To
1 <u>WATER ZONE</u>	<u>3621</u>				
2					
3					

### WATER SANDS

Name	From	To	Water Level	Name	From	To	Water Level
1							
2							
3							

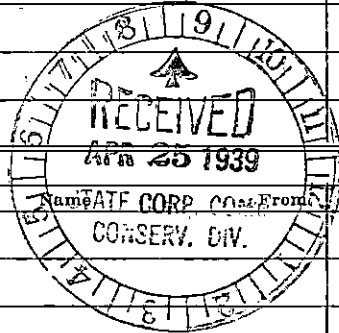


### CASING RECORD

Size	Wt.	Thds.	Make	Amount Set		Amount Pulled		Packer Record			
				Ft.	In.	Ft.	In.	Size	Length	Depth Set	Make
<u>10 1/2 OD</u>	<u>35.75</u>	<u>8</u>		<u>274</u>	<u>7</u>	<u>(Threads off - landed at 272')</u>					
<u>7 OD</u>	<u>22</u>	<u>10</u>	<u>Nat'l</u>	<u>362.8</u>	<u>3</u>	<u>(Threads off - landed at 362.5')</u>					

Liner Record: Amount \_\_\_\_\_ Kind \_\_\_\_\_ Top \_\_\_\_\_ Bottom \_\_\_\_\_

### CEMENTING AND MUDDING RECORD

Size	Amount Set		Sacks Cement	Chemical		Method Cementing	Amount	Mudding Method	Results (See Note)
	Feet	In.		Gal.	Make				
<u>10 1/2 OD</u>	<u>279</u>	<u>3</u>	<u>250</u>	<u>Incor</u>		<u>Halliburton</u>			
<u>7 OD</u>	<u>361.6</u>	<u>9</u>	<u>125</u>	<u>Ash Grove</u>		<u>Halliburton</u>			

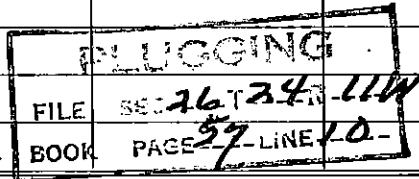

NOTE: What method was used to protect sands when outer strings were pulled? \_\_\_\_\_

NOTE: Were bottom hole plugs used? \_\_\_\_\_ If so, state kind, depth set and results obtained \_\_\_\_\_

### TOOLS USED

Rotary tools were used from 0 feet to 3533 feet, and from \_\_\_\_\_ feet to \_\_\_\_\_ feet.  
 Cable tools were used from 3833 feet to 4020 feet, and from \_\_\_\_\_ feet to \_\_\_\_\_ feet.  
 Type Rig \_\_\_\_\_

### PRODUCTION DATA

Temporarily abandoned May 10, 1938, as a dry hole  
 Production first 24 hours \_\_\_\_\_ bbls. Gravity \_\_\_\_\_, Emulsion \_\_\_\_\_ per cent., Water \_\_\_\_\_ per cent.  
 Production second 24 hours \_\_\_\_\_ bbls. Gravity \_\_\_\_\_, Emulsion \_\_\_\_\_ per cent., Water \_\_\_\_\_ per cent.  
 If gas well, cubic feet per 24 hours \_\_\_\_\_ Rock Pressure, lbs. per square inch \_\_\_\_\_

I, the undersigned, being first duly sworn upon oath, state that this well record is true, correct and complete according to the records of this office and to the best of my knowledge and belief.

W. Snyder Prod. Foreman  
Name and Title

Subscribed and sworn to before me this the 24th day of April, 1938.

My commission expires September 14, 1942  
Notary Public.

FORMATION RECORD

Give detailed description and thickness of all formations drilled through and contents of sand, whether dry, water, oil or gas.

Formation	Top	Bottom	Formation	Top	Bottom
Surface, clay and sand	0	84	<u>Cable Tools</u>		
Sand and shale	84	160			
Red bed shells	160	314	<u>Core #1 - 3/5' recovery</u>		
Red bed shale	314	563			
Red bed, shale, shells	563	760	Sand, medium crystals, slight show oil	3533	3537
Shale and shells	760	1540	Chert, with very slight show oil	3637	3638
Line, sandy	1540	1670			
Sandy line and shale	1670	1710	<u>Core #2 - 3/4' recovery</u>		
Line	1710	1815			
Shale and line	1815	2672	Dolomite, cherty, show oil	3538	3842
Broken line	2672	2709			
Line	2709	2730	<u>Drilled</u>		
Shale and line	2730	2830	Line	3842	3857
Shale and line shells	2830	2900	Steel line correction	3857	3853
Shale and line	2900	2925	Line	3853	3956
Line	2925	2953	Green shale	3956	3960
Shale and line	2953	2958	Line	3960	3962
Line	2958	3245	Green shale	3962	3964
Shale	3245	3295	Line	3964	3968
Shale and line	3295	3331	Green shale	3968	3976
Shale and shells	3331	3351	Line	3976	3979
Shale	3351	3392	Green shale	3979	3982
<u>Top Lansing</u>	3392		Line	3982	3989
Line	3392	3502	Green shale	3989	4000
Chert	3502	3512	Line	4000	4011
Line	3512	3660	Shale	4011	4014
Shale and line	3660	3700	Line	4014	4015
Steel line correction	3700	3710	Shale	4015	4018
Shale and line	3710	3737	Line	4018	4020
Chert and line	3737	3744			
Shale and line	3744	3795	<u>Total Depth</u>	4020	
Derrick floor correction	3795	3793			
<u>Core #1 - 12 1/13' recovery</u>					
Shale, red and green, interbedded	3793	3806	Date first work	February 24, 1938	
<u>Core #2 - 17/17' recovery</u>			Date drilling started	March 6, 1938	
Shale, green	3806	3819	Date drilling completed	May 6, 1938	
Shale, sandy, pyritic	3819	3821	Date well completed as a dry hole	May 6, 1938	
Limestone, fair crystals to medium crystals, cherty very faint oil odor	3821	3823	Date temporarily abandoned	May 10, 1938	
<u>Top Chert</u>	3821				
<u>Core #3 - 3 1/4' recovery</u>					
Line, with fair to medium crystals	3823	3825			
Sand with good show oil	3825	3827			
<u>Top Sand</u>	3825				
Line	3827	3828			
<u>Core #4 - 3/5' recovery</u>					
Sand, coarse with good oil saturation	3828	3833			