

STATE OF KANSAS  
STATE CORPORATION COMMISSION

WELL PLUGGING RECORD

Give All Information Completely  
Make Required Affidavit  
Mail or Deliver Report to:  
Conservation Division  
State Corporation Commission  
212 No. Market  
Wichita, Kansas

Pratt County, Sec. 6 Twp. 26 Rge. 11 (E) (W) x

Location as "NE/CNW/SW" or footage from lines C SW NW

Lease Owner Imperial Oil Co.

Lease Name Block Well No. #2

Office Address Box 784, Great Bend, Kansas 67530

Character of Well (completed as Oil, Gas or Dry Hole)

Date well completed 19

Application for plugging filed 1-23-68 19

Application for plugging approved 19


Plugging commenced 1-25-68 19

Plugging completed 1-29-68 19

Reason for abandonment of well or producing formation

If a producing well is abandoned, date of last production 19

Was permission obtained from the Conservation Division or its agents before plugging was commenced?

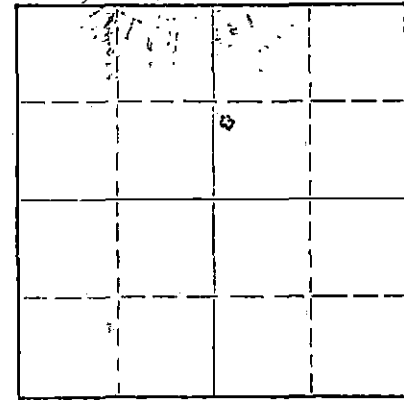

Locate well correctly on above Section Plat

Name of Conservation Agent who supervised plugging of this well Archie Elving

Producing-formation Depth to top Bottom Total Depth of Well 4164' Feet

Show depth and thickness of all water, oil and gas formations.

OIL, GAS OR WATER RECORDS

CASING RECORD

FORMATION	CONTENT	FRDM	TD	SIZE	PUT IN	PULLED OUT
				4 1/2"	4160'	3531.70'
				8 5/8"	980'	

Describe in detail the manner in which the well was plugged, indicating where the mud fluid was placed and the method or methods used in introducing it into the hole. If cement or other plugs were used, state the character of same and depth placed, from feet to feet for each plug set.

Made bottom hole plug back with sand to 4100'. Mixed and ran 5 sacks cement thru dump bailer.  
Mudded hole to 400', set 25' rock bridge. Filled hole with 6 yards ready mix from 375' to base of cellar.

RECEIVED  
STATE CORPORATION COMMISSION  
JAN 31 1968  
CONSERVATION DIVISION  
Wichita, Kansas

1-31-68

(If additional description is necessary, use BACK of this sheet)

Name of Plugging Contractor Southwest Casing Pulling Co., Inc.


Address Box 364, Great Bend, Kansas

STATE OF Kansas, COUNTY OF Barton, ss.  
Southwest Casing Pulling Co., Inc. (employee of owner) or (owner or operator) of the above-described well, being first duly sworn on oath, says: That I have knowledge of the facts, statements, and matters herein contained and the log of the above-described well as filed and that the same are true and correct. So help me God.

(Signature) W. C. Spencer  
Box 364, Great Bend, Kansas  
(Address)

SUBSCRIBED AND SWORN to before me this 30 day of January, 1968

My commission expires October 1968

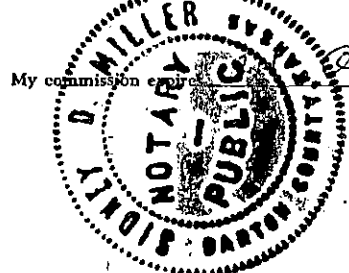

Sidney Miller  
Notary Public.