

STATE OF KANSAS
STATE CORPORATION COMMISSION


WELL PLUGGING RECORD

Give All Information Completely
Make Required Affidavit
Mail or Deliver Report to:
Conservation Division
State Corporation Commission
800 Bitting Building
Wichita, Kansas

Pratt County. Sec. 7 Twp. 26 Rge. 11 (E) (W)
Location as "NE/CNW $\frac{1}{4}$ /SW $\frac{1}{4}$ " or footage from lines Ctr. SW/4 SW/4

Lease Owner Lion Oil Company
Lease Name Moeller Well No. 2
Office Address P. O. Box 639, Pratt, Kansas

Character of Well (completed as Oil, Gas or Dry Hole) Dry Hole
Date well completed 7-12 19 43
Application for plugging filed 3-24 19 52
Application for plugging approved 3-27 19 52
Plugging commenced 4-6 19 52
Plugging completed 4-15 19 52
Reason for abandonment of well or producing formation Well had ceased to produce enough Oil to be marketable
If a producing well is abandoned, date of last production 2-9 19 51
Was permission obtained from the Conservation Division or its agents before plugging was commenced? Yes

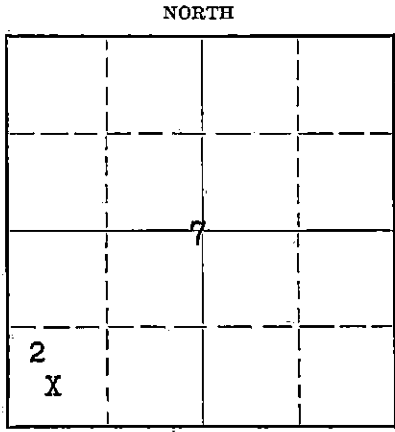

Locate well correctly on above Section Plat

Name of Conservation Agent who supervised plugging of this well Merle Rives
Producing formation Depth to top Bottom Total Depth of Well 4151 Feet
Show depth and thickness of all water, oil and gas formations.

OIL, GAS OR WATER RECORDS

CASING RECORD

Formation	Content	From	To	Size	Put In	Pulled Out
				8-5/8"	298'	0'
				5-1/2"	4147'	2881'

Describe in detail the manner in which the well was plugged, indicating where the mud fluid was placed and the method or methods used in introducing it into the hole. If cement or other plugs were used, state the character of same and depth placed, from feet to feet for each plug set.

Sanded hole from 4151' to 4140' and ran 5 sacks of cement. Mudded hole to 250', set 10' rock bridge and ran 15 sacks of cement. Mudded hole to 35' and ran 10 sacks of cement.

(If additional description is necessary, use BACK of this sheet)

Name of Plugging Contractor West Supply Company
Address Chase, Kansas

STATE OF KANSAS COUNTY OF PRATT
Vernon Hayes (employee of owner) or (owner or operator) of the above-described well,

being first duly sworn on oath, says: That I have knowledge of the facts, statements, and matters herein contained and the log of the above-described well as filed and that the same are true and correct. So help me God.

(Signature) Vernon Hayes
P. O. Box 639, Pratt, Kansas (Address)

SUBSCRIBED AND SWORN to before me this 17th day of April 19 52
Notary Public.

My commission expires August 29, 1955

PLUGGING
FILE SEC 7 T 26 R 116
BOOK PAGE 4 LINE 7

APR 19 1952 4-19-52
CONSERVATION DIVISION
Wichita, Kansas

LION OIL REFINING COMPANY
El Dorado, Arkansas

Moeller Well No. 2

Center of SW $\frac{1}{4}$ of the SW $\frac{1}{4}$ of Sec. 7,
Twp. 26S, Rge. 11W, Pratt County,
Kansas.

Contractor: The R. W. Rine Drilling Company
Commenced: June 8, 1943 Completed: July 3, 1943

	LOG	
Clay & Sand	Top- 90	
Sand	120	
Sand & Shale	220	
Red Bed	300	8-5/8" casing cemented at 300'
Red Bed & Shale	650	
Shale & Shells	1695	
Lime	1720	
Broken Lime	1810	
Lime	1970	
Shale	1980	
Lime	2020	
Shale & Shells	2051	
Sand & Shale	2135	
Shale	2270	
Lime	2410	
Broken Lime	2485	Top Kansas City Lime 3618 D.F.
Shale	2760	" Viola " 4147 D.F.
Shale & Shells	2820	
Lime	2950	
Shale	3085	
Lime	3215	
Shale	3225	
Lime	3245	
Lime & Shale Breaks	3330	
Lime	3455	
Shale	3465	
Lime	3604	
Lime & Shale	3680	
Lime	3739	
Lime & Chert	3777	
Lime	3970	
Chert	4027	
Chert & Shale	4046	
Shale	4149	5 1/2" casing at 4150'
Lime	4153	Total Depth 4153'
		Drill Stem Test at 4153' - 650' oil in 15 min.

State of Kansas)
County of Barton) ss.

I, C. H. Todd, do hereby certify that the above is a true and correct copy of the log of Moeller Well no. 2, located in the center of the SW $\frac{1}{4}$ of the SW $\frac{1}{4}$ of Section 7, Township 26S, Range 11W, Pratt County, Kansas.

C. H. Todd

Sworn to and subscribed before me this 6th day of July, 1943.

C. O. Deighton

My commission expires December 4th, 1943.

4-1-52

PLUGGING
FILE SEC 7 T 26 R 11 W
BOOK PAGE 4 LINE 7

1943
SECTION
Pratt County, Kansas