

15-151-19117-00-00

STATE OF KANSAS
STATE CORPORATION COMMISSION


WELL PLUGGING RECORD

Give All Information Completely
Make Required Affidavit
Mail or Deliver Report to:
Conservation Division
State Corporation Commission
800 Biting Building
Wichita, Kansas

FORMATION PLUGGING RECORD

Strike out upper line
when reporting plug-
ging off formations.

County. Sec. 7 Twp. 26 Rge. (R) 11 (W)
Location as "NE $\frac{1}{4}$ NW $\frac{1}{4}$ SW $\frac{1}{4}$ " or footage from lines Ctr. NW/4 SW/4

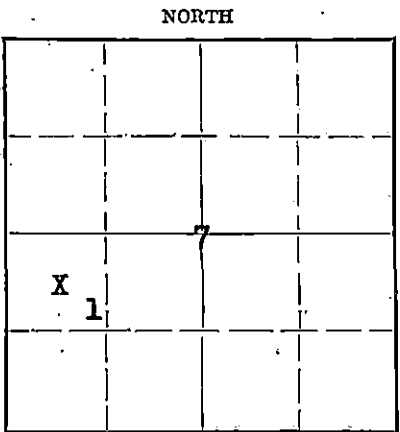

Locate well correctly on above
Section Plat

Lease Owner Lion Oil Company
Lease Name Moeller Well No. 1
Office Address P. O. Box 639, Pratt, Kansas
Character of Well (completed as Oil, Gas or Dry Hole) Dry Hole
Date well completed 6-15 19 43
Application for plugging filed 3-24 19 52
Application for plugging approved 3-27 19 52
Plugging commenced 4-16 19 52
Plugging completed 4-25 19 52
Reason for abandonment of well or producing formation Well had ceased to
produce enough Oil to be marketable.
If a producing well is abandoned, date of last production April 19 52
Was permission obtained from the Conservation Division or its agents before plugging was com-
menced? Yes

Name of Conservation Agent who supervised plugging of this well Merle Rives
Producing formation _____ Depth to top _____ Bottom _____ Total Depth of Well 4143 Feet
Show depth and thickness of all water, oil and gas formations.

OIL, GAS OR WATER RECORDS CASING RECORD

Formation	Content	From	To	Size	Put In	Pulled Out
				8-5/8"	295'	0'
				5-1/2"	4134'	2005'

Describe in detail the manner in which the well was plugged, indicating where the mud fluid was placed and the method or methods used in introducing it into the hole. If cement or other plugs were used, state the character of same and depth placed, from _____ feet to _____ feet for each plug set.

Sanded hole from 4143' to 4125' and ran 5
sacks of cement. Mudded hole to 275', set
10' rock bridge and ran 15 sacks of cement.
Mudded hole to 35', set rock bridge and ran
10 sacks of cement. Plugging completed.

Plugging Contractor: West Supply Company
Chase, Kansas

(If additional description is necessary, use BACK of this sheet)
Correspondence regarding this well should be addressed to Joe Costello
Address P. O. Box 639
Pratt, Kansas

STATE OF Kansas, COUNTY OF Pratt, ss.

Joe Costello (employee of owner) ~~is~~ of the above-described well,
being first duly sworn on oath, says: That I have knowledge of the facts, statements, and matters herein contained and the log of the above-
described well as filed and that the same are true and correct. So help me God.

(Signature) Joe Costello
P. O. Box 639, Pratt, Kansas
(Address)

SUBSCRIBED AND SWORN to before me this 28th day of April 19 52

My commission expires August 29, 1955 **RECEIVED** Van Saubek Notary Public.

STATE CORPORATION COMMISSION
22-2825 2-48-16M
APR 29 1952
CONSERVATION DIVISION
Wichita, Kansas

PLUGGING
FILE SEC 7-T-26R(11W)
BOOK PAGE 4 LINE 6

LION OIL REFINING COMPANY
El Dorado, Arkansas

Moeller Well No. 1

660' south of north line and 660'
east of west line of SW $\frac{1}{4}$ of Sec. 7,
Twp. 26S, Rge. 11W, Pratt County,
Kansas

Elevation: 1859'

Contractor: The R. W. Rine Drilling Company

Commenced: May 12, 1943

Completed: June 8, 1943

LOG

Clay	Top- 141	
Sand & Shale	141- 280	
Red Bed	280- 458	8-5/8" Casing Cemented at 295'
Red Rock & Shale	458-1050	
Shale & Shells	1050-1250	
Salt	1250-1350	
Shale & Shells	1350-1670	
Lime & Shale Breaks	1670-1775	
Lime	1775-1858	
Lime & Chert	1858-1880	
Lime & Shale	1880-2045	
Sand	2045-2080	
Lime	2080-2237	
Lime & Shale Breaks	2237-2305	
Lime	2305-2384	Top Kansas City Lime 3615' corrected
Lime & Shale	2384-2580	Soft 3638-46; slight show oil.
Shale	2580-2660	Drill Stem Test 3638-46; 90' mud in 30 min
Lime & Shale	2660-2770	Top Mississippi Lime 3977' corrected
Shale	2770-2815	Top Viola Lime 4134' corrected
Lime & Shale	2815-3440	Drill Stem Test 4134-39 corrected;
Shale	3440-3465	300' oil in 14 min.
Lime	3465-3530	
Lime & Shale	3530-3615	
Lime	3615-3979	
Chert	3979-4037	
Chert & Shale	4037-4070	
Lime & Shale	4070-4141	Total Depth - 4139 corrected

State of Kansas) ss.
County of Barton)

I, C. H. Todd, do hereby certify that the above is a true and correct copy of the log of Moeller Well No. 1 located 660' south of north line and 660' east of west line of SW $\frac{1}{4}$ of Sec. 7, Twp. 26S, Rge. 11W, Pratt County, Kansas.

C. H. Todd

Sworn to and subscribed before me this 9th day of June, 1943.

PLUGGING
FRI 2507-126R11W
BOOK PAGE 4 LINE 6

M. D. Chubb
(Notary Public)

My commission expires July 26 1944.

4-1-52