

STATE OF KANSAS  
STATE CORPORATION COMMISSION

WELL PLUGGING RECORD

Give All Information Completely  
Make Required Affidavit  
Mail or Deliver Report to:  
Conservation Division  
State Corporation Commission  
800 Bittling Building  
Wichita, Kansas

OR  
FORMATION PLUGGING RECORD Strike out upper line when reporting plugging of formations.

Pratt County. Sec 7 Twp 26S Rge 11 (W)  
Ctr. W/2 SW/4

Location as "NE 1/4 NW 1/4 SW 1/4" or footage from lines

Lease Owner Lion Oil Company

Lease Name Moeller Well No. 3

Office Address P. O. Box 639, Pratt, Kansas

Character of Well (completed as Oil, Gas or Dry Hole) Dry Hole

Date well completed 11-7 19 45

Application for plugging filed 3-24 19 52

Application for plugging approved 3-27 19 52


Plugging commenced 4-2 19 52

Plugging completed 4-6 19 52

Reason for abandonment of well or producing formation Well had ceased to produce enough Oil to be marketable.

If a producing well is abandoned, date of last production 2-24 19 51

Was permission obtained from the Conservation Division or its agents before plugging was commenced? Yes

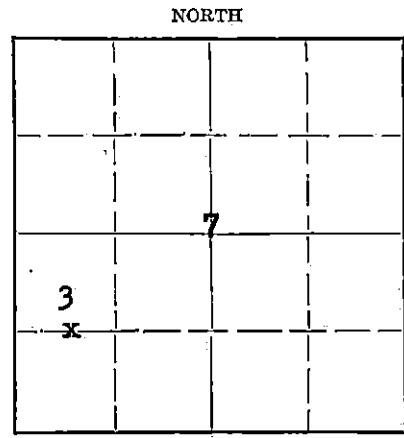

Locate well correctly on above Section Plat

Name of Conservation Agent who supervised plugging of this well Merle Rives

Producing formation Depth to top Bottom Total Depth of Well 4154 Feet

Show depth and thickness of all water, oil and gas formations.

OIL, GAS OR WATER RECORDS

CASING RECORD

Formation	Content	From	To	Size	Put In	Pulled Out
				8-5/8"	320'	0'
				5-1/2"	4146'	2669'

Describe in detail the manner in which the well was plugged, indicating where the mud fluid was placed and the method or methods used in introducing it into the hole. If cement or other plugs were used, state the character of same and depth placed, from feet to feet for each plug set.

Sanded hole from 4154' to 4140' and ran 5 sacks of cement. Mudded hole to 250', set 10' rock bridge and ran 15 sacks of cement. Mudded hole to 35', set rock bridge and ran 10 sacks of cement.

STATE OF KANSAS  
APR 9 1952 4-9-52  
CONSERVATION DIVISION  
Wichita, Kansas

Plugging Contractor - West Supply Company  
Chase, Kansas

(If additional description is necessary, use BACK of this sheet)

Correspondence regarding this well should be addressed to Vernon Hayes  
Address P. O. Box 639  
Pratt, Kansas

STATE OF Kansas, COUNTY OF Pratt, ss.  
Vernon Hayes (employee of owner)

being first duly sworn on oath, says: That I have knowledge of the facts, statements, and matters herein contained and the log of the above-described well as filed and that the same are true and correct. So help me God.

(Signature) Vernon Hayes  
P. O. Box 639, Pratt, Kansas  
(Address)

SUBSCRIBED AND SWORN to before me this 8th day of April, 19 52

Van Dousek  
Notary Public.

My commission expires August 29, 1955

PLUGGING  
FILE SEC 7 T 26 R 11 W  
BOOK PAGE 4 LINE 8

