

STATE OF KANSAS
STATE CORPORATION COMMISSION


WELL PLUGGING RECORD

OR
FORMATION PLUGGING RECORD

Strike out upper line when reporting plugging of formations.

Give All Information Completely
Make Required Affidavit
Mail or Deliver Report to:
Conservation Division
State Corporation Commission
800 Bittling Building
Wichita, Kansas

NORTH

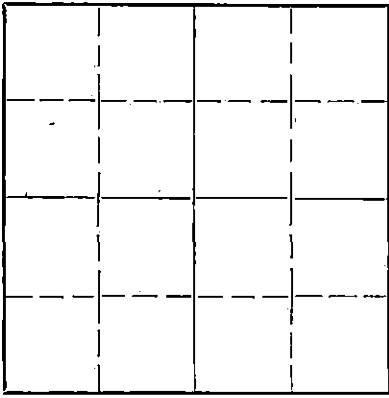

Locate well correctly on above Section Plat

Pratt County, Sec. 7 Twp. 26 Rge. 11 (E) (W)
Location as "NE 1/4 NW 1/4 SW 1/4" or footage from lines... NE SW 660' S of NE 880' W of EL
Lease Owner... Transwestern Oil Company
Lease Name... Moeller Well No. 1
Office Address... Milam Building San Antonio, Texas
Character of Well (completed as Oil, Gas or Dry Hole)... Dry Hole
Date well completed... August 20 19 43
Application for plugging filed... August 20 19 43
Application for plugging approved... August 20 19 43
Plugging commenced... August 20 19 43
Plugging completed... August 20, 1943 19
Reason for abandonment of well or producing formation... Dry Hole

If a producing well is abandoned, date of last production... 19
Was permission obtained from the Conservation Division or its agents before plugging was commenced? By Telephone

Name of Conservation Agent who supervised plugging of this well... Durkee
Producing formation... None Depth to top... Bottom... Total Depth of Well 3174 Feet
Show depth and thickness of all water, oil and gas formations.

OIL, GAS OR WATER RECORDS

CASING RECORD

Formation	Content	From	To	Size	Put In	Pulled Out
				10-3/4"	529	None

Describe in detail the manner in which the well was plugged, indicating where the mud fluid was placed and the method or methods used in introducing it into the hold. If cement or other plugs were used, state the character of same and depth placed, from... feet to ... feet for each plug set.

Pumped Hole w/ Heavy Mud w/ Drill Pipe every 1000'
1 st Plug @ 360' w/ 25 Sx Cement
2 nd " @ 40' w/ 20 Sx "
Plate welded over casing in cellar.
Cement for plugs run thru drill pipe

PLUGGING
FILE 7-26-1110
BOOK PAGE 88 LINE 20

PLUGGED
AUG 21 1943

8-24-43

(If additional description is necessary, use BACK of this sheet)

Correspondence regarding this well should be addressed to J.A. Traugher
Address Bush ton, Kansas

STATE OF... COUNTY OF... ss.
(employee of owner) or (owner or operator) of the above-described well,
being first duly sworn on oath, says: That I have knowledge of the facts, statements, and matters herein contained and the log of the above-described well as filed and that the same are true and correct. So help me God.

(Signature) J.A. Traugher
Bush ton, Kans (Address)

SUBSCRIBED AND SWORN to before me this 23 day of August, 19 43

My commission expires Feb. 1, 1947

Notary Public.



TRANSWESTERN OIL COMPANY

Moeller #1 -- Stark Pool
7026-11 Stafford County

Pratt

Formation	Thickness	Total Depth
Cellar	12	12
Surface Clay	18	30
Sand & Gravel	45	75
Sand & Shells	90	165
Shells & Red Bed	220	385
Shale & Shells	100	485
Red Bed	163	648
Anhydrite	7	655
Shale, Shells, Red Bed	150	805
Red Bed & Shale	145	950
Shale & Shells	260	1210
Salt & Shale	230	1440
Shale & Shells	170	1610
Lime & Shale	207	1817
Shale & Shells	41	1858
Sharp Sandy Line, Shale & Chert	39	1889
Shale & Shells	21	1910
Hard Sharp Line	65	1975
Lime & Shale	55	2030
Sharp Lime	57	2087
Cherty Lime	26	2113
Sharp Lime & Shale	92	2205
Shale & Lime	29	2234
Shale & Lime	376	2610
Shale & Shells	185	2795
Shale	20	2815
Shale & Shells	75	2890
Lime & Shale	200	3090
Lime	100	3190
Lime & Shale	82	3272
Sandy Lime	13	3285
Lime	121	3406
Lime & Shale	137	3543
Sandy Shale & Lime	12	3555
Shale & Lime	30	3585
Shale	15	3600
Lime & Shale	16	3616
Lansing Lime	24	3640
Porous Lime	10	3650
Lime	15	3665
Cherty Lime	28	3693
Lime	19	3712
Soft Lime (Some Odor)	10	3722
Lime & Shale	31	3753
Sharp Hard Lime	25	3778
Shale & Lime	36	3814
Soft Lime	6	3820
Sharp Lime	39	3859
Chert	6	3865
Lime	11	3876
Lime & Shale	118	3994
Shale & Lime - Cherty	20	4014
Sharp Lime	31	4045
Lime & Shale	14	4059
Cherty Lime & Shale	10	4069
Lime & Shale	96	4165
Lime	9	4174 TD

Drill stem Test to TD 8-20-43 - Drill Pipe filled 1000' with Water in 15 minutes. Dry & Abandoned 8-20-43. TD 4174.

8-24-43

PLI...
FIL... 7 26 11W
BOOK... 88 2.0