


STATE OF KANSAS STATE CORPORATION COMMISSION

Give All Information Completely Make Required Affidavit Mail or Deliver Report to: Conservation Division State Corporation Commission P. O. Box 17027 Wichita, Kansas 67217 NORTH

WELL PLUGGING RECORD

Reno County, Sec. 28 Twp. 22S Rge. 10W (E) (W) X

Location as "NE/CNW&SW" or footage from lines C NE NW Lease Owner James E. Russell Petroleum, Inc. Lease Name Moore Estate Well No. 1 Office Address Box 2618, Abilene, Texas 79604 Character of Well (completed as Oil, Gas or Dry Hole) D & A Date well completed June 10 19 74 Application for plugging filed June 10 19 74 Application for plugging approved June 10 19 74 Plugging commenced June 10 19 74 Plugging completed June 10 19 74 Reason for abandonment of well or producing formation D & A

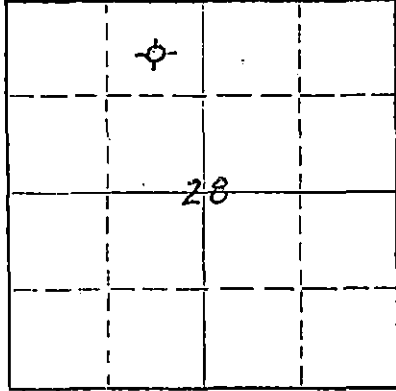

Locate well correctly on above Section Plat

If a producing well is abandoned, date of last production 19 Was permission obtained from the Conservation Division or its agents before plugging was commenced? Yes

Name of Conservation Agent who supervised plugging of this well Mr. Gilbert Toman Producing formation Depth to top Bottom Total Depth of Well 3664 Feet Show depth and thickness of all water, oil and gas formations.

OIL, GAS OR WATER RECORDS

CASING RECORD

Table with 7 columns: FORMATION, CONTENT, FROM, TO, SIZE, PUT IN, PULLED OUT. Row 1: SIZE 8-5/8", PUT IN 280', PULLED OUT -0-

Describe in detail the manner in which the well was plugged, indicating where the mud fluid was placed and the method or methods used in introducing it into the hole. If cement or other plugs were used, state the character of same and depth placed, from feet to feet for each plug set.

Plug @ 420' w/40 sx cmt Plug @ 275' w-25 sx hulls Plug @ 40' w/10 sx cmt

RECEIVED STATE CORPORATION COMMISSION JUN 21 1974 CONSERVATION DIVISION Wichita, Kansas

(If additional description is necessary, use BACK of this sheet)


Name of Plugging Contractor Red Tiger Drilling Company Address 1720 Wichita Plaza, Wichita, Kansas 67202

STATE OF Kansas COUNTY OF Sedgwick Linda H. Dickens (employee of owner) or (owner or operator) of the above-described well, being first duly sworn on oath, says: That I have knowledge of the facts, statements, and matters herein contained and the log of the above-described well as filed and that the same are true and correct. So help me God.

(Signature) Linda H. Dickens 1720 Wichita Plaza, Wichita, Kansas 67202 (Address)

SUBSCRIBED AND SWORN to before me this 13th day of June, 1974

My commission expires

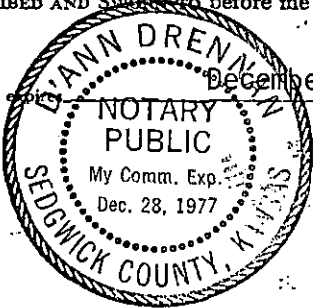

December 28, 1977

(Signature) D'Ann Drennon Notary Public.

DRILLERS LOG

No. 1 Moore Estate

| | | | |
|----------------|-------------|----------------------------|--------------|
| CASING RECORD: | COMPANY: | James E. Russell Petroleum | DESCRIPTION: |
| 8-5/8" @ 280' | CONTRACTOR: | Red Tiger Drilling Co. | C NE NW |
| w/225' sx cmt | COMMENCED: | May 30, 1974 | 28-22S-10W |
| | COMPLETED: | June 10, 1974 | Reno County, |
| | | | Kansas |

ELEVATION: 1764 Gr.

| <u>FORMATION</u> | <u>FROM</u> | <u>TO</u> | <u>REMARKS</u> |
|-------------------------------|-------------|-----------|----------------|
| Sand | 0 | 220 | |
| Shale | 220 | 419 | |
| Anhydrite | 419 | 424 | |
| Shale | 424 | 1410 | |
| Shale & Lime | 1410 | 1565 | |
| Lime & Shale | 1565 | 1740 | |
| Shale & Lime | 1740 | 1890 | |
| Lime & Shale | 1890 | 2090 | |
| Shale & Lime | 2090 | 2462 | |
| Lime | 2462 | 2480 | |
| Lime & Shale | 2480 | 2640 | |
| Shale & Lime | 2640 | 2740 | |
| Lime | 2740 | 3030 | |
| Shale & Lime | 3030 | 3230 | |
| Lime | 3230 | 3535 | |
| Shale & Chert | 3535 | 3559 | |
| Conglomerate | 3559 | 3575 | |
| Chert, Shale & Sand | 3575 | 3615 | |
| Chert, Sand, Shale & Dolomite | 3615 | 3660 | |
| Dolomite | 3660 | 3664 | |

RECEIVED
STATE CORPORATION COMMISSION
JUN 21 1974
CONSERVATION DIVISION
Wichita, Kansas

I certify that this is a true and correct copy of the above log to the best of my knowledge.

RED TIGER DRILLING COMPANY

Linda H. Dickens
Linda H. Dickens

Subscribed and sworn to before me this 13th day of June, 1974.

Dianne Drennan
Notary Public

